

MISSISSIPPI DEPARTMENT OF NATURAL RESOURCES

Bureau of Land and Water Resources

Southport Mall

P.O. Box 10631

Jackson, Mississippi 39209

WATER WELL DRILLERS LOG

Wilkinson
Q2007

Oct 16 19 81 Perma Well Dr. Wilkinson
 date well completed firm name county well located

OWNER: Phill Chapman
~~...~~

Woodville
 (mailing address)

WELL LOCATION:
 sec. 25 T. 1 N. R. 2 E
12 miles W. SW of Woodville
 (distance) (direction) (nearest town)

WELL PURPOSE: Home
 (home, irrigation, municipal, industrial)

WELL COMPLETION DATA:

- (1) diameter (inches) 4"
- (2) total depth (feet) 205
- (3) static water level (feet) 135 below top of ground.
- (4) casing plastic bottom
 (material) (depth)
- (size) if telescope see back.
- (5) screen 10' 195'
 (length) (depth to top)
- 4" plastic
 (size) (material)
- (6) pump 15
 (HP) (yield gpm)
- split
 (type power)
- (7) electric log no
 (yes or no)
- (organization running log)

(8) how well bottom plugged:
back wash

DRILLERS REMARKS:

description of formations encountered	from	to
<u>Red Clay</u>	<u>0</u>	<u>25</u>
<u>Red sand & Gravel</u>	<u>25</u>	<u>80</u>
<u>Gravel</u>	<u>80</u>	<u>95</u>
<u>Clay</u>	<u>95</u>	<u>190</u>
<u>Coarse sand</u>	<u>190</u>	<u>205</u>


DEPT. OF NATURAL RESOURCES
 BUREAU OF LAND & WATER RESOURCES

JUN 15 1982

RECEIVED

If well telescopes please sketch and show depths.

GROUND LEVEL

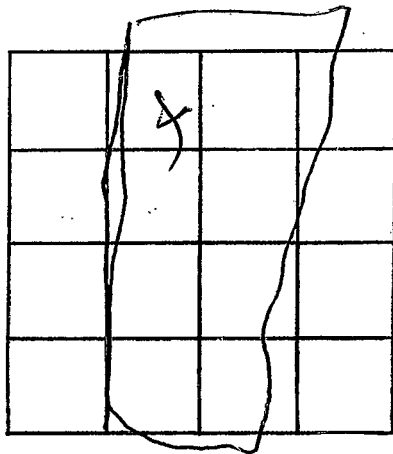

SECTION 25

Please indicate well location X.

ADDITIONAL INFORMATION

If more than one screen,
show locations of each on sketch.