

*Wilkinson*  
 Q 2010

MISSISSIPPI DEPARTMENT OF NATURAL RESOURCES  
 Bureau of Land and Water Resources  
 Southport Mall  
 P.O. Box 10631  
 Jackson, Mississippi 39209  
**WATER WELL DRILLERS LOG**

3-15 1983 Rayhorn Drilling & Const. Co. Wilkinson  
 date well completed firm name county well located

LANDOWNER:  
 Nathaniel Nelson  
 Woodville, Ms  
 (mailing address)

WELL LOCATION:  
 sec. 2, T-1(N) R-3(E)  
 8 miles SW of Woodville  
 (distance) (direction) (nearest town)

WELL PURPOSE: *farm*  
 (home, irrigation, municipal, industrial)

WELL COMPLETION DATA:

(1) diameter (inches) 4"

(2) total depth (feet) 348'

(3) static water level (feet) 300' below above top of ground.

(4) casing PVC, 338'  
 (material) (depth)  
4" if telescope see back.  
 (size)

(5) screen 10', 338'  
 (length) (depth to top)  
4" PVC  
 (size) (material)

(6) pump 3/4 66gpm  
 (HP) (yield gpm)  
elec  
 (type power)

(7) electric log NO  
 (yes or no)

(organization running log)

(8) how well bottom plugged Wood Plug

description of formations encountered	from	to
Top soil	0	4
Chalk	4	40
Sand	40	80
Chalk	80	190
sand	190	300
Chalk	300	330
Sand	330	348

DEPT. OF NATURAL RESOURCES  
 BUREAU OF LAND & WATER RESOURCES


MAR 21 1983

RECEIVED

DRILLERS REMARKS:

If well telescopes please  
sketch and show depths.

GROUND LEVEL

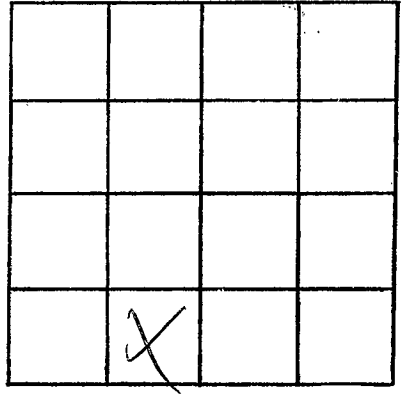

SECTION 2

Please indicate well location X.

ADDITIONAL INFORMATION

If more than one screen,  
show locations of each on sketch.