

Wilkinson
R2
10-18-68

MISSISSIPPI
BOARD OF WATER COMMISSIONERS
416 North State Street
Jackson, Mississippi 39201

CODED

WATER WELL DRILLERS LOG

Oct 74 date well completed
H. R. Kennell & Sons firm name
Wilkinson county well located

LANDOWNER: Charles
Henderson
baton rouge - La -
(mailing address)

description of formations encountered	from	to
Red clay	0	16
Red chalk	16	54
White chalk	54	112
fine pink sand	112	128
hard white chalk	128	175
medium coarse sand	175	206

WELL LOCATION:
sec. 14 T. 1 N. R. 2 W.
2 1/2 miles S. Woodville
(distance) (direction) (nearest town)

WELL PURPOSE:
(home, irrigation, municipal, industrial)
same

- WELL COMPLETION DATA:
- (1) diameter (inches) 4"
 - (2) total depth (feet) 206
 - (3) static water level (feet) 93 below top of ground.
 - (4) casing Plastic bottom (material) (depth)
 - (5) screen 6' (length) 20' (depth to top) plastic (material)
 - (6) pump 1/2 HP (type power) 10 (yield gpm)
 - (7) electric log no (yes or no)

(organization running log)
(8) how well bottom plugged wooden plug -


DRILLERS REMARKS: NO. 6 Previous good well -

DEC 10 1968

MISS. BD. OF
WATER COMM.

If well telescopes please sketch and show depths.

GROUND LEVEL

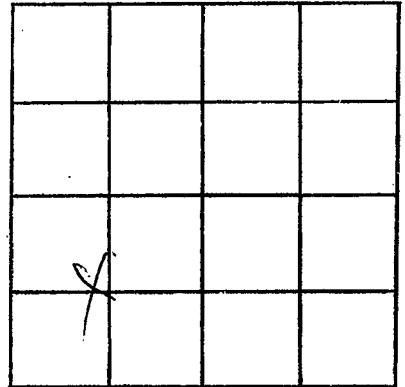

SECTION 14

Please indicate well location X.

ADDITIONAL INFORMATION

If more than one screen, show locations of each on sketch.