

PH
Wilkinson
R 3
5-18-70

MISSISSIPPI
 BOARD OF WATER COMMISSIONERS
 416 North State Street
 Jackson, Mississippi 39201

WATER WELL DRILLERS LOG

May 18 19 70 Shiner Water Well, Sec. Wilkinson
 date well completed firm name county well located

LANDOWNER:
Leona Miner
Woodville, Miss.
 (mailing address) 060

description of formations encountered	from	to
<u>Top Soil</u>	<u>0</u>	<u>2</u>
<u>Clay</u>	<u>2</u>	<u>75</u>
<u>sand</u>	<u>75</u>	<u>133</u>

WELL LOCATION:
 sec. 2 T 1 N R 2 E
2 miles South ^{west} of Woodville
 (distance) (direction) (nearest town)

WELL PURPOSE: None
 (home, irrigation, municipal, industrial)

- WELL COMPLETION DATA:
- (1) diameter (inches) 2"
 - (2) total depth (feet) 133'
 - (3) static water level (feet) 55' ^{below} _{above} top of ground.
 - (4) casing Galv. 136'
 (material) (depth)
2" if telescope see back.
 (size)
 - (5) screen 5' 136'
 (length) (depth to top)
2" S.S.
 (size) (material)
 - (6) pump 1 76 gpm
 (HP) (yield gpm)
elec.
 (type power)
 - (7) electric log no
 (yes or no)

(organization running log)
 (8) how well bottom plugged Wood Plug


DRILLERS REMARKS:

JUN 2 1970

MISS. BD. OF
 WATER COMMISSIONERS

If well telescopes please sketch and show depths.

GROUND LEVEL

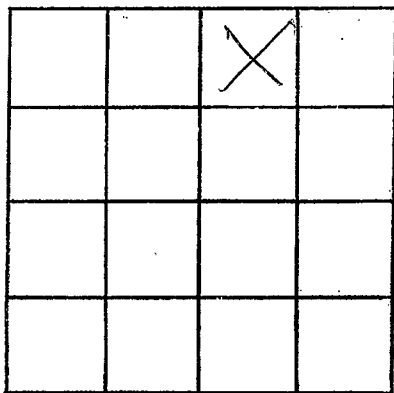

SECTION 2

Please indicate well location X.

ADDITIONAL INFORMATION

If more than one screen,
show locations of each on sketch.