

WILKINSON  
R 4  
9-4-70

MISSISSIPPI  
BOARD OF WATER COMMISSIONERS  
416 North State Street  
Jackson, Mississippi 39201

**CODED**

WATERWELL DRILLERS LOG

Sept 4 1970 date well completed  
Chester Keener wilkinson firm name  
county well located

LANDOWNER: Sharp Berry  
RFD Woodville  
(mailing address)

description of formations encountered	from	to
Red clay	0	16
Red cherty sand	16	97
Sand & gravel	97	107
Sandy sand	107	126
Coarse sand	126	141

WELL LOCATION:  
sec 35 T 1 N R 2 E  
9 miles SSW of Woodville  
(distance) (direction) (nearest town)

WELL PURPOSE: House  
(home, irrigation, municipal, industrial)

- WELL COMPLETION DATA:
- (1) diameter (inches) 4"
  - (2) total depth (feet) 141
  - (3) static water level (feet) 78 below top of ground.
  - (4) casing Plastic Bottom-  
(material) (depth)
  - (size) If telescope see back.
  - (5) screen 6' 135  
(length) (depth) to top
  - (size) 4" Plastic  
(material)
  - (6) pump 1/2 Sub 12  
(HP) (yield gpm)
  - (type power) elect
  - (7) electric log No  
(yes or no)
  - (organization running log)

**CODED**


(8) how well bottom plugged  
wooden plug

DRILLERS REMARKS:  
old 2" well had-

OCT 14 1970

If well telescopes please sketch and show depths.

GROUND LEVEL

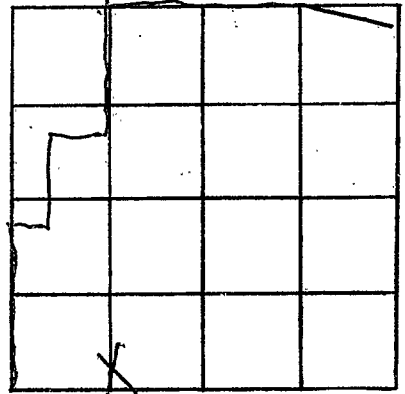

SECTION 38

Please indicate well location X.

ADDITIONAL INFORMATION

If more than one screen,  
show locations of each on sketch.