

WILKINSON  
R5  
9-10-70

MISSISSIPPI  
BOARD OF WATER COMMISSIONERS  
416 North State Street  
Jackson, Mississippi 39201

**CODED**

WATER WELL DRILLERS LOG

Sept 10 1970 date well completed  
Chattanooga Wilkerson firm name  
Wilkerson county well located

LANDOWNER: Tommey O. Whitaker - P.O. Woodville  
(mailing address)

description of formations encountered	from	to
	clay	0
fine sand & chalk	30	90
chalk	90	106
sewer	106	124

WELL LOCATION:  
sec 37 T 1 N R 2 E  
9 miles SSE Woodville  
(distance) (direction) (nearest town)

WELL PURPOSE: land  
(home, irrigation, municipal, industrial)

- WELL COMPLETION DATA:
- (1) diameter (inches) 4"
  - (2) total depth (feet) 124
  - (3) static water level (feet) 87 below top of ground
  - (4) casing Plastic Ballou  
(material) (depth)
  - (size) if telescope see back.
  - (5) screen 6' 118'  
(length) (depth to top)
  - 4" Plastic  
(size) (material)
  - (6) pump 3/4 Sub 15  
(HP) (yield gpm)
  - Elect  
(type power)
  - (7) electric log Elect NO  
(yes or no)
  - (organization running log)

**CODED**

(8) how well bottom plugged woodruff


DRILLERS REMARKS: old 2" well had

097 14 1970

MISS. BD. OF  
WATER COMM

If well telescopes please sketch and show depths.

GROUND LEVEL

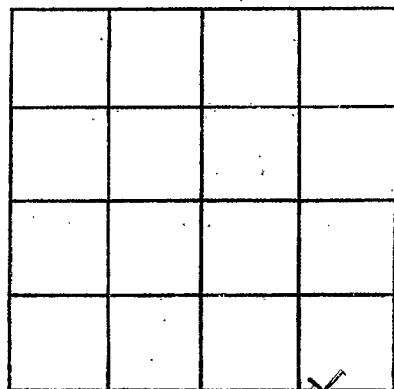

SECTION 32

Please indicate well location X.

ADDITIONAL INFORMATION

If more than one screen,  
show locations of each on sketch.