

WILKINSON

~~ADAMS~~

R6

10-2-70

MISSISSIPPI
BOARD OF WATER COMMISSIONERS
416 North State Street
Jackson, Mississippi 39201

CODED

WATER WELL DRILLERS LOG

WILKINSON
~~ADAMS~~

10/2
date well completed

HERRINGTON WELL SERVICE
firm name

county well located

LANDOWNER: THEO. B. HAWLTON

description of formations
encountered

from to

Baton Rouge, La.
(mailing address)

Clay	0	30
sandy clay & gravel	30	60
sandy clay	60	90
clay + gravel	90	110
loose sand	110	125
sand	125	149

WELL LOCATION:

sec. 35 T1 N R E
8 miles SW of WOODVILLE
(distance) (direction) (nearest town)

WELL PURPOSE: DOMESTIC
(home, irrigation, municipal, industrial)

WELL COMPLETION DATA:

- (1) diameter (inches) 2"
- (2) total depth (feet) 147'
- (3) static water level (feet) 100' below top of ground.
- (4) casing galv pipe, 142'
(material) (depth)

 if telescope see back.
(size)

- (5) screen 5' Monell, 147'
(length) (depth to top)
- 2"
(size) Monell
(material)

- (6) pump Jet 1 4
(HP) (yield gpm)
- Electric
(type power)

- (7) electric log NO
(yes or no)

(organization running log)

- (8) how well bottom plugged B.W. valves

DRILLERS REMARKS:


CODED

OCT 30 1970

MISS. BD. OF
WATER COMM.

If well telescopes please sketch and show depths.

GROUND LEVEL

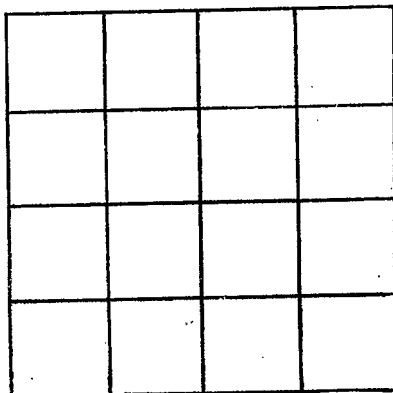

SECTION _____

Please indicate well location X.

ADDITIONAL INFORMATION

If more than one screen, show locations of each on sketch.