

Resale
WILKINSON
R 7
2-24-71

MISSISSIPPI
 BOARD OF WATER COMMISSIONERS
 416 North State Street
 Jackson, Mississippi 39201

CODED

WATER WELL DRILLERS LOG

2-24 19 71 Grimes Water Well, Sec. Wilkinson
 date well completed firm name county well located

LANDOWNER:	description of formations encountered	from	to
<u>Mary Whitaker</u> (mailing address)			
	<u>Red Clay</u>	<u>1</u>	<u>6</u>
	<u>Gray clay</u>	<u>6</u>	<u>70</u>
	<u>Sand</u>	<u>70</u>	<u>90</u>
	<u>Blue Clay</u>	<u>90</u>	<u>145</u>
	<u>Sand</u>	<u>145</u>	<u>189</u>
WELL LOCATION: sec. <u>20</u> T. <u>1</u> N. R. <u>2</u> E <u>7</u> miles <u>South</u> of <u>Woodville</u> (distance) (direction) (nearest town)			
WELL PURPOSE: <u>Home</u> (home, irrigation, municipal, industrial)			
WELL COMPLETION DATA:			
(1) diameter (inches) <u>2"</u>			
(2) total depth (feet) <u>189'</u>			
(3) static water level (feet) <u>101'</u> <u>below</u> top of ground.			
(4) casing <u>Duct.</u> <u>182'</u> (material) (depth) <u>2"</u> If telescope see back. (size)			
(5) screen <u>5'</u> <u>182'</u> (length) (depth to top) <u>2"</u> <u>SS.</u> (size) (material)			
(6) pump <u>1 1/2</u> <u>8</u> (HP) (yield gpm) <u>elec.</u> (type power)			
(7) electric log <u>no.</u> (yes or no) (organization running log)			
(8) how well bottom plugged <u>Wood Plug</u>			
DRILLERS REMARKS:			


CODED

MAR 9 1971

MISS. BD. CG
 WATER COMM.

If well telescopes please sketch and show depths.

GROUND LEVEL

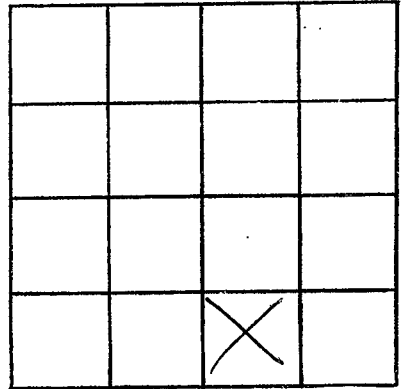

SECTION _____

Please indicate well location X.

ADDITIONAL INFORMATION

If more than one screen,
show locations of each on sketch.