

WILKINSON  
R 8  
6-1-71

MISSISSIPPI  
BOARD OF WATER COMMISSIONERS  
416 North State Street  
Jackson, Mississippi 39201

WATER WELL DRILLERS LOG

**CODED**

date well completed 19 6/1/71 firm name H.E. BRINTON WATER DRILLING WILKINSON county well located

LANDOWNER: Angie Tract  
Lease to FARRAR FARMS  
St Francisville La  
(mailing address)

description of formations encountered	from	to
Clay	0	30'
sand & gravel	30	120
Clay	120	225
sand	225	230
Clay	230	460
sand	460	482

WELL LOCATION:

sec. 18 T L R 20  
5 miles S of WOODVILLE  
(distance) (direction) (nearest town)

WELL PURPOSE: Farm  
(home, irrigation, municipal, industrial)

WELL COMPLETION DATA:

- (1) diameter (inches) 2"  
(2) total depth (feet) 482  
(3) static water level (feet) 230' below above top of ground.  
(4) casing galv 472'  
(material) (depth)  
2" if telescope see back.  
(size)  
(5) screen 10' 472'  
(length) (depth to top)  
2" SS STEEL  
(size) (material)  
(6) pump 2 air 8 gpm  
(HP) (yield gpm)  
Electric  
(type power)  
(7) electric log NO  
(yes or no)

(organization running log)

- (8) how well bottom plugged BNV

DRILLERS REMARKS:


**CODED**

JUN 28 1971

MISS. BD. OF  
WATER COMM.

If well telescopes please sketch and show depths.

GROUND LEVEL

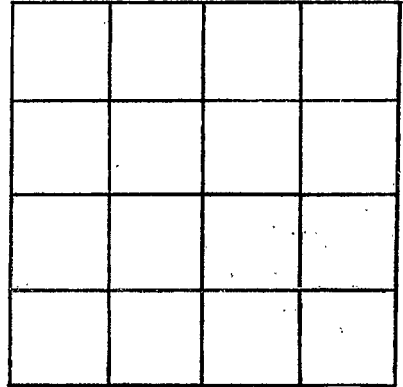

SECTION \_\_\_\_\_

Please indicate well location X.

ADDITIONAL INFORMATION

If more than one screen,  
show locations of each on sketch.