

Walter

WILKINSON
R 9
5-18-71

MISSISSIPPI
BOARD OF WATER COMMISSIONERS
416 North State Street
Jackson, Mississippi 39201

CODED

WATER WELL DRILLERS LOG

5-18 date well completed 1971 Griner Water Well Service Wilkinson firm name county well located

LANDOWNER:
George Ogden
#4 Box 230
Woodville, Miss.
(mailing address)

description of formations encountered	from	to
top Soil	0	2
Clay	2	70
Sand	70	112

WELL LOCATION:
sec. 18 T. 1 N R. 2 E
6 miles South of Woodville
(distance) (direction) (nearest town)

WELL PURPOSE: Home
(home, irrigation, municipal, industrial)

- WELL COMPLETION DATA:
- (1) diameter (inches) 2"
 - (2) total depth (feet) 112'
 - (3) static water level (feet) 33' below top of ground
 - (4) casing (material) Galv. (depth) 125'
 - 2" (size) if telescope see back.
 - (5) screen (length) 5' (depth to top) 105'
 - 2" (size) (material) SS
 - (6) pump 1/2 (HP) 56 gpm (yield gpm)
 - elec. (type power)
 - (7) electric log NO (yes or no)
 - (organization running log)
 - (8) how well bottom plugged Wood Plug

CODED


JUN 9 @ 1971

DRILLERS REMARKS:

MISSISSIPPI
BOARD OF WATER COMMISSIONERS

If well telescopes please sketch and show depths.

GROUND LEVEL

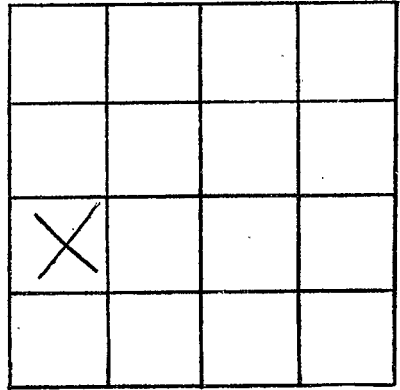

SECTION 18

Please indicate well location X.

ADDITIONAL INFORMATION

If more than one screen,
show locations of each on sketch.