

WILKINSON
R 11
7-11-72

MISSISSIPPI
 BOARD OF WATER COMMISSIONERS
 416 North State Street
 Jackson, Mississippi 39201

WATER WELL DRILLERS LOG

7-11 1972 James Water Well Ser. Wilkinson
 date well completed firm name county well located


LANDOWNER:	description of formations encountered	from	to
<u>Mary Temple</u> <u>Woodville, Miss.</u> (mailing address)			
	<u>clay</u>	<u>2</u>	<u>178</u>
	<u>sand</u>	<u>178</u>	<u>217</u>
WELL LOCATION:			
sec. <u>19</u> T- <u>1</u> N R- <u>2</u> E <u>7</u> miles <u>south</u> of <u>Woodville</u> (distance) (direction) (nearest town)			
WELL PURPOSE: <u>none</u> (home, irrigation, municipal, industrial)			
WELL COMPLETION DATA:			
(1) diameter (inches) <u>2" 3"</u>			
(2) total depth (feet) <u>217'</u>			
(3) static water level (feet) <u>105'</u> below above top of ground.			
(4) casing <u>Gal.</u> <u>210'</u> (material) (depth)			
<u>2"</u> if telescope see back. (size)			
(5) screen <u>5'</u> <u>210'</u> (length) (depth to top)			
<u>2"</u> " <u>55"</u> (size) (material)			
(6) pump <u>1 A.P.</u> <u>5 GPM</u> (HP) (yield gpm)			
<u>elec.</u> (type power)			
(7) electric log <u>no</u> (yes or no)			
(organization running log)			
(8) how well bottom plugged <u>wood plug</u>			
DRILLERS REMARKS:			

JUL 11 1972

MAKER FORM

If well telescopes please sketch and show depths.

GROUND LEVEL

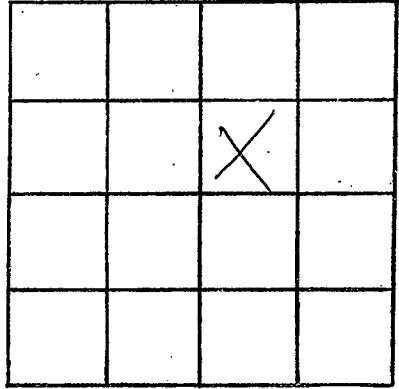

SECTION 19

Please indicate well location X.

ADDITIONAL INFORMATION

Lined area for additional information.

If more than one screen, show locations of each on sketch.