

WILKINSON
R 12
9-29-72

MISSISSIPPI
BOARD OF WATER COMMISSIONERS
416 North State Street
Jackson, Mississippi 39201

CODED

WATER WELL DRILLERS LOG

Wilkinson
Madison

Sept 29 1972 date well completed
Chester Renee firm name
Madison county well located

LANDOWNER: Feltus Davis
ATD Woodville
(mailing address)

WELL LOCATION:
sec. 19 T. 1 N. R. 2 W.
4 miles SSE of Woodville
(distance) (direction) (nearest town)

WELL PURPOSE: Home
(home, irrigation, municipal, industrial)

- WELL COMPLETION DATA:
- (1) diameter (inches) 2"
 - (2) total depth (feet) 149
 - (3) static water level (feet) 60 below top of ground.
 - (4) casing steel (material) bottom (depth)
 - if telescope see back.
 - (5) screen 5' (length) 144 (depth to top)
1 1/2" (size) stainless steel (material)
 - (6) pump air system (HP) (yield gpm)
hyalites (type/power)
 - (7) electric log no (yes or no)

(organization running log)

(8) how well bottom plugged
wooden plug

DRILLERS REMARKS:


description of formations encountered	from	to
clay	0	14
Red sand	14	77
loosely sand	77	135
coarse sand and pea gravel	135	144

CODED

DEC 4 1972

If well telescopes please sketch and show depths.

GROUND LEVEL

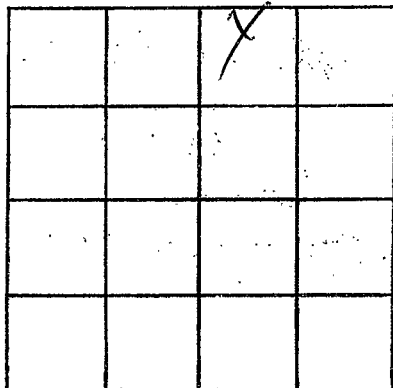

SECTION 19

Please indicate well location X.

ADDITIONAL INFORMATION

If more than one screen,
show locations of each on sketch.