

WILKINSON  
R 15  
4-11-74

MISSISSIPPI  
BOARD OF WATER COMMISSIONERS  
416 North State Street  
Jackson, Mississippi 39201

WATER WELL DRILLERS LOG

WILKINSON **CODED**

April 11 1974 Chester Leavelle well WILKINSON  
date well completed firm name county well located

LANDOWNER: James Co - Woodville, Miss -  
(mailing address)

WELL LOCATION:  
sec. 2 T. 1 N. R. 2E  
2 miles SE of Woodville  
(distance) (direction) (nearest town)

WELL PURPOSE: Industrial  
(home, irrigation, municipal, industrial)

WELL COMPLETION DATA:  
(1) diameter (inches) 4"  
(2) total depth (feet) 160  
(3) static water level (feet) 32 below top of ground  
(4) casing Plast Bottom  
(material) (depth)  
(size) If telescope see back.  
(5) screen 20 140'  
(length) (depth to top)  
4" Plast  
(size) (material)  
(6) pump 5 Sub 70  
(HP) (yield gpm)  
ghost  
(type power)  
(7) electric log no  
(yes or no)  
(organization running log)  
(8) how well bottom plugged  
wooden plug


description of formations encountered	from	to
clay	0	10
pink check	12	28
fine sand	28	40
red clink	40	55
fine white sand	55	90
coarse sand & gravel	80	85
gray check & gravel	95	120
fine white sand	120	141
coarse white sand & gravel	141	160

DRILLERS REMARKS:  
pumped with air at rate of 150 gal/min

RECEIVED  
OCT 29 1974

If well telescopes please sketch and show depths.

GROUND LEVEL

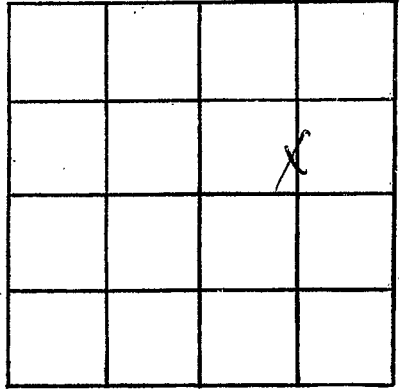

SECTION 2

Please indicate well location X.

ADDITIONAL INFORMATION

If more than one screen, show locations of each on sketch.