

WILKINSON  
R 18

Bureau of Land and Water Resources  
Southport Mall  
P.O. Box 10631

Jackson, Mississippi 39209  
WATER WELL DRILLERS LOG

10-8-80

Oct 8 1980 Acers well for Wilkerson  
date well completed firm name county well located


LANDOWNER:  
Ben. Davis  
Rt Woodville  
(mailing address)

description of formations encountered	CODED	
	from	to
sand clay	0	22
Red Chalky sand	22	75
pink Chalk	75	90
pink tobby	90	125
Coarse sand	125	137

WELL LOCATION:  
sec. 9 T. 1 N. R. 2 W.  
4 1/2 miles W. SW of Woodville  
(distance) (direction) (nearest town)

WELL PURPOSE: home  
(home, irrigation, municipal, industrial)

- WELL COMPLETION DATA:
- (1) diameter (inches) 4"
  - (2) total depth (feet) 137
  - (3) static water level (feet) 108 below top of ground.
  - (4) casing plastic bottom (material) (depth)
  - (size) if telescope see back.
  - (5) screen 5' 134' (length) (depth to top)
  - 4" plastic (size) (material)
  - (6) pump 3 hp 10 (HP) (yield gpm)
  - electric (type power)
  - (7) electric log 20 (yes or no)
  - (organization running log)

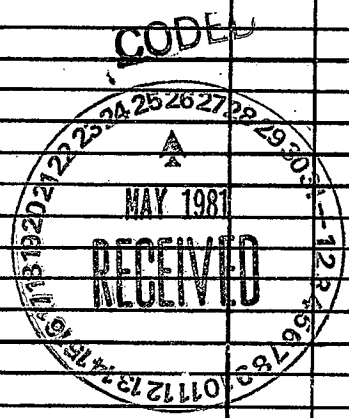


(8) how well bottom plugged  
Backwash Valve

DRILLERS REMARKS:  
old 9" well  
pumped out

If well telescopes please sketch and show depths.

GROUND LEVEL

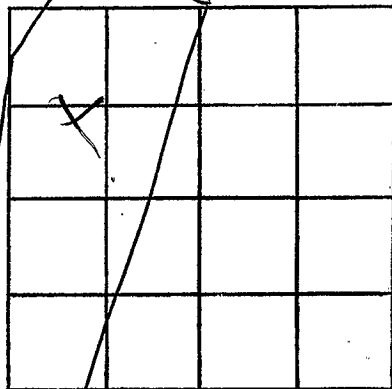

SECTION 9

Please indicate well location X.

ADDITIONAL INFORMATION

If more than one screen,  
show locations of each on sketch.