

MISSISSIPPI DEPARTMENT OF NATURAL RESOURCES

Bureau of Land and Water Resources

Southport Mall

P.O. Box 10631

Jackson, Mississippi 39209

WATER WELL DRILLERS LOG

CODED

WILKINSON
R 19
7/11/83

Griner Drilling Service, Inc.

Wilkinson

7-11-83
date well completed

Griner Drilling Service, Inc.
firm name

Wilkinson
county well located

LANDOWNER:	description of formations encountered	from	to
BESORO Petroleum 1726 1/2 10th Street Laurel, MS 39440 (mailing address)	clay, gravel	0	63
	SAND	63	126
WELL LOCATION: sec. 19 T. 10 S. R. 2 NE/CO No. 1 T.M. Voth Unit Woodville 5/20/83 (direction) (nearest town)	SAND, pea gravel	126	252
WELL PURPOSE: oilfield supply (home, irrigation, municipal, industrial)			
WELL COMPLETION DATA:			
(1) diameter (inches) 3"	RXN CORP.		
(2) total depth (feet) 273'	PR. NE 1 COR SEC 19, 9		
(3) static water level (feet) 80' (below above top of ground)	WILY also SEC 12 E 350, 7th S. 1/2, 0 PA 500'		
(4) casing Steel 253' (material) (depth) 3" if telescope see back.			
(5) screen 42' 210' (length) (depth to top) 3" perforated (size) (material)			
(6) pump AC (HP) (yield gpm)			
(7) electric log (yes or no)			
(organization running log)			
(8) how well bottom plugged Orange peel			
DRILLERS REMARKS:			

CODED

CODED


DEPT. OF NATURAL RESOURCES
BUREAU OF LAND & WATER RESOURCES

AUG 4 1983

RECEIVED

If well telescopes please sketch and show depths.

GROUND LEVEL

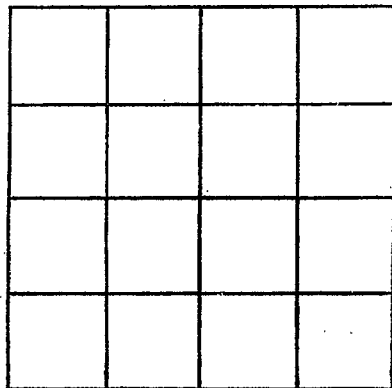

SECTION _____

Please indicate well location X.

ADDITIONAL INFORMATION

If more than one screen, show locations of each on sketch.