

WILKINSON  
R 20

MISSISSIPPI DEPARTMENT OF NATURAL RESOURCES  
Bureau of Land and Water Resources  
Southport Mall  
P.O. Box 10631

Jackson, Mississippi 39209  
WATER WELL DRILLERS LOG

CODED

April 10 1984 *Reems Miller* Wilkinson  
date well completed firm name county well located

LANDOWNER:  
*James Batest*  
*Wt Woodville*  
(mailing address)

description of formations encountered	from	to
<i>black soil</i>	<i>0</i>	<i>20</i>
<i>Red sand</i>	<i>20</i>	<i>50</i>
<i>sand + small gravel</i>	<i>50</i>	<i>115</i>
<i>pebbles + shells</i>	<i>115</i>	<i>150</i>
<i>fine sand</i>	<i>150</i>	<i>180</i>
<i>Coarse sand</i>	<i>180</i>	<i>220</i>

WELL LOCATION:  
sec. *31* T *1* N R *2* E  
*6* miles *South* of *Woodville*  
(distance) (direction) (nearest town)

WELL PURPOSE: *Home*  
(home, irrigation, municipal, industrial)

WELL COMPLETION DATA:

- (1) diameter (inches) *4"*
- (2) total depth (feet) *220*
- (3) static water level (feet) *100* below above top of ground.
- (4) casing *plastic*, *bottom*  
(material) (depth)  
*12* if telescope see back.  
(size)
- (5) screen *6"*, *194'*  
(length) (depth to top)  
*4"*, *plastic*  
(size) (material)
- (6) pump *3/4* *12*  
(HP) (yield gpm)  
*shot*  
(type power)
- (7) electric log *No*  
(yes or no)  
(organization running log)
- (8) how well bottom plugged *back up*

DRILLERS REMARKS:


DEPT. OF NATURAL RESOURCES  
BUREAU OF LAND & WATER RESOURCES

JUL - 2 1984

RECEIVED

If well telescopes please sketch and show depths.

GROUND LEVEL

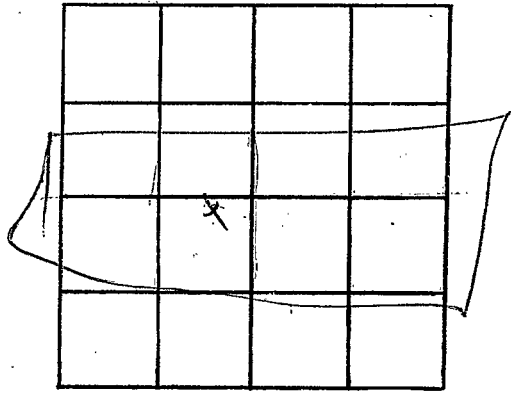

SECTION 31

Please indicate well location X.

ADDITIONAL INFORMATION

If more than one screen,  
show locations of each on sketch.