

Wilkinson
R22

MISSISSIPPI DEPARTMENT OF NATURAL RESOURCES
Bureau of Land and Water Resources
Southport Mall
P.O. Box 10631
Jackson, Mississippi 39209
WATER WELL DRILLERS LOG

CODED

7/8 1985 Brumfield Water Well Drilling Co. (Wilkinson Co.)
date well completed firm name county well located

LANDOWNER: R. E. Williams Drilling
3100 Walnut Grove Rd. Suite 102
Memphis, Tenn.
(mailing address)

Description of formations encountered	from	to
Top Soil	0	40
Clay - Red + White	40	80
Chalk	90	140
Shale	140	150
Sand	150	200

WELL LOCATION:
sec. 32 T. 1 N R. 2 W
20 miles South W of Woodville
(distance) (direction) (nearest town)

WELL PURPOSE: Supply
(home, irrigation, municipal, industrial)

- WELL COMPLETION DATA:
- (1) diameter (inches) 4"
 - (2) total depth (feet) 200 Ft.
 - (3) static water level (feet) 80' below above top of ground.
 - (4) casing PVC, 180
(material) (depth)
(size) if telescope see back.
 - (5) screen 20', 180'
(length) (depth to top)
4", PVC
(size) (material)
 - (6) pump 3, 35-40
(HP) (yield gpm)
Electric
(type power)
 - (7) electric log No
(yes or no)
(organization running log)
 - (8) how well bottom plugged Backwell
Value.

RECEIVED


JUN 22 1987

Department of Natural Resources
Bureau of Land & Water Resources

DRILLERS REMARKS:
Well has stage kept
Pulled & Plugged with
Cement.

If well telescopes please sketch and show depths.

GROUND LEVEL

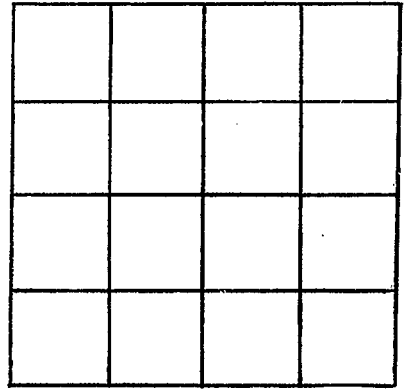

SECTION _____

Please indicate well location X.

ADDITIONAL INFORMATION

If more than one screen,
show locations of each on sketch.