

MISSISSIPPI DEPARTMENT OF NATURAL RESOURCES

Bureau of Land and Water Resources

Southport Mall

P.O. Box 10631

Jackson, Mississippi 39209

WATER WELL DRILLERS LOG

WILKINSON
R23

Caled

Dec 3 1988
date well completed

Morris Brothers, Inc.
firm name

Wilkinson
county well located

LANDOWNER: Mid-South

1824 Capital Tower

Jackson, Miss 39201
(mailing address)

WELL LOCATION:

sec. 31 T. 1 (N) R. 2 (E)
S W
11 miles S of Liberty
(distance) (direction) (nearest town)

WELL PURPOSE: Rig Supply
(home, irrigation, municipal, industrial)

WELL COMPLETION DATA:

- (1) diameter (inches) 4
- (2) total depth (feet) 230
- (3) static water level (feet) 55 below top of ground.
- (4) casing steel 168'
(material) (depth)
4" If telescope see back.
(size)
- (5) screen 30' 168'
(length) (depth to top)
4" PVC
(size) (material)
- (6) pump 5 60+
(HP) (yield gpm)
Electric
(type power)
- (7) electric log no
(yes or no)

(organization running log)
- (8) how well bottom plugged BWV

description of formations encountered

from

to

Topsoil	0	20
Sand	20	40
Peagravel	40	60
clay	60	120
washrock + sand	120	170
clay	170	180
course sand	180	230

RECEIVED



DEC 12 1988

Department of Natural Resources
Bureau of Land & Water Resources

DRILLERS REMARKS:

If well telescopes please sketch and show depths.

GROUND LEVEL

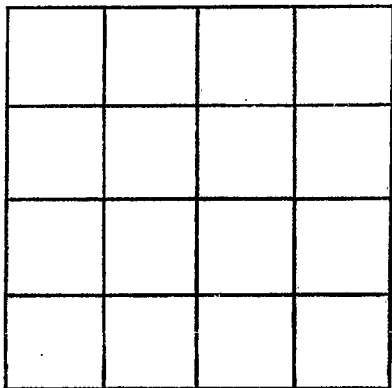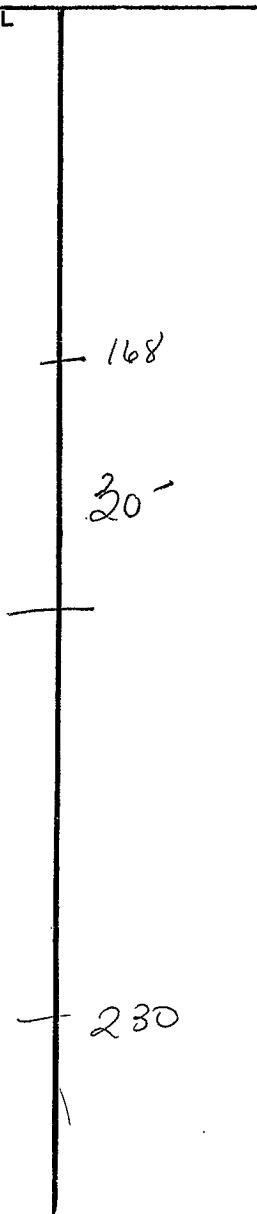

SECTION _____

Please indicate well location X.

ADDITIONAL INFORMATION

Lined area for additional information.

If more than one screen, show locations of each on sketch.