County: Wilkinson	STATE WELL REPORT Part 1	For Office Use Only:
Permit #:	Driller's Log	Well #:
Driller: Gary Raybon	Mississippi Department of Environmental Quality Office of Land and Water Resources	Aquifer:
Date drilling completed: 2/29/16	P.O. Box 2309 Jackson, MS 39225-2309	E-Log #:
	(601)961-5210	

State Law requires that this report be prepared by the license holder responsible for the work and filed with the Department at the above address within 30 days of completion of drilling of the well or borehole.

(601)360-0535 (fax)

Department at the above huaress manne 50 mays of con	spicatori of anima of the new of estended
Well Owner Information	Well or Borehole Location
(Landowner if borehole is not for a water well)	Latitude: <u>30°59'58"N</u> Longitude: <u>91°16'36'W</u>
Owner Name: Mitchell Whitaker	Method of Lat/Long (check one): Conventional Survey,
Mailing Address: <u>POBox 787</u>	
· · · · · · · · · · · · · · · · · · ·	USGS quad, Hand-held GPS, Survey-grade GPS
Woodville MS 39669	<u>510 4 55 4, sec 32 T IN R 2W</u>
City State Zip Code	<u>9 Miles SE of Woodville</u>
Telephone No. (601) 888-3426	(Distance) (Direction) (Nearest Town)
Well / B	orehole Data
	$\frac{2/29/16}{16}$ Hole depth: $100'$ Hole diameter: $4''$
Location of the source of any surface water used for drilli	1
Method of dosing and volume of Chlorine used in drilling a	nd development:
Logs run (circle all applicable): No log run Electric Gamm	na Ray Density Sonic Neutron Other:
Name of organization running log(s):	
Purpose of borehole (circle one): (Water Well Geotechn	ical/Geological Investigation Ground Source Heat Pump
Seismic Survey Other	(describe)
If drilling is not related to water well c	onstruction, skip the remainder of this block
Purpose of Well (circle all applicable): Home Industrial	Public Supply Irrigation Fish Culture
Other (describe):	
If a flowing well, method of flow regulation: Valve	
Static Water Level: <u>55</u> feet [above or below (circle one)	Wand surface Date measured: $\frac{2/29/16}{29}$
Method of measurement (circle one): Steel tape (Electric	tape Air line Other (describe):
	feet Type of grout (circle one). Neat Cement Bentonite Mix
Casing length: <u>70</u> feet Casing diameter:	
Screen length: <u>20</u> feet Screen diameter: _	
Screen slot size: <u>O(O</u> inches Setting depth	
Type of completion (circle all applicable) Gravel packed	) Underreamed Open hole Natural Development
Other (describe):	
Top of lap pipe or reduction in casing:feet	
If telescoped or more than	one screen, describe on next page

Form: OLWR-SWR-1A (4/13)


County:	Wilkinson
Permit #:	

## For Office Use Only:

Well #: \_\_\_\_\_

The sketch below only required for water wells

If well telescopes, show depths on sketch.

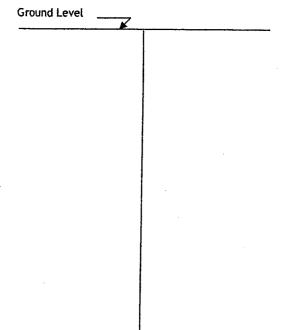

Description of formations encountered must be provided for all wells and boreholes, unless specifically exempted by regulations

Description of Formations Encountered	From (depth)	To (depth)
Clay	Ground level	15
Gravel	15	20
Sand/claystreaks	20	40
Ene sand	40	60
Coarse sand	60	100
· · · · · · · · · · · · · · · · · · ·		
· · · · · · · · · · · · · · · · · · ·		
	·	· · · · ·
······································		

If more than one screen, show location of each on sketch

Sketch the property layout and include the following: 1) the well location 2) any permanent structures on the property that may aid in locating the well 3) any roads, power lines, or other ite 4) north arrow ocation of We side on right ny Go 2.3 miles down Whitaker Rd. Well is 200 yds west on right side of 2 barn. Landowner Name: Mitche ( ) White I HEREBY CERTIFY that the well/borehole was drilled, constructed, and completed in accordance with all applicable requirements of the Mississippi Department of Environmental Quality and the Mississippi Department of Health regulations, if applicable, and state laws. Kayborn Drilling TAC. 0-60 3/1/16 Print Name of Responsible Licensee and License No. Date Signature of Li

For CLWR-SWR-1A (4/13)

STATE W	<b>ELL REPORT</b>		
County: WIRIASON Part 2 Permit #: Pump Installer's Completion Report		For Office Use Only: Well #: <u><u>R</u> 74</u>	
Driller: <u>GONY Keyborn</u> Office of Lai	nd and Water Resources P.O. Box 2309 on, MS 39225-2309	Aquifer:	
<u>Copy information from block on Part 1</u> (601	(601) 360-0535 (fax)		
This part of the report must be completed by a licensed water of the report must be attached and both parts filed with the D	Department at the above address w	vithin 30 days of well completion.	
Well Owner Information Owner Name: Mitchell Whitaker	Well L Latitude: 30,59,58 N Lon	ngitude: <u>91°16′36″</u> W	
Mailing Address: <u>PO Box 787</u>		): Conventional Survey,	
	USGS quad, Hand-held G	PS, Survey-grade GPS	
Woodville MS 39669 City State Zip Code		32 TIN R2W	
Telephone No. (601) 888-3426	$\frac{9}{(Distance)}$ Miles $\frac{5E}{(Direction)}$ of	f Wood ville (Nearest Town)	
	pe (circle one)		
Submersible Turbine Air Lift Centrifugal Flowing Well	•	scribe):	
Date Pump Installed:	Rated Pump Capacity:	Gallons Per Minute	
Is This Pump (circle one): (New) Repaired Replacement			
	pe (circle one)		
Electric Diesel Gasoline Natural Gas Tractor PTO Win Horse Power Rating of Motor: Setting Dept			
Date Well Tested:			
Static Water Level (A): <u>55</u> Feet Below Land Surface	• •		
Drawdown [(B) - (A)]:Feet Below Land Surf		Gallons Per Minute	
Method of measurement (circle one): Steel tape Electric ta	ape) Air line Other ( <i>describe</i> ):_ ta for Flowing Well		
	tu for i towing wea		
measured shut in nead: Ieet.			
Measured shut in head:feet. Well yieldedGPM with a drawdown of	feet_after	hours of pumping	
Well yieldedGPM with a drawdown of	feet after	hours of pumping	
Well yieldedGPM with a drawdown of Meter	Installation	_hours of pumping	
Well yieldedGPM with a drawdown of Meter Manufacturer:	Installation		
Well yieldedGPM with a drawdown of Meter Manufacturer:	Installation Meter Serial Number: Type of Meter:		
Well yieldedGPM with a drawdown of Meter Manufacturer: Meter Model Number/Name:	Installation Meter Serial Number: Type of Meter: I x 1000, ets):		
Well yieldedGPM with a drawdown of Meter Manufacturer: Meter Model Number/Name: Totalizer Register Unit and Multiplier Factor (AF x .001, gal	Installation Meter Serial Number: Type of Meter: I x 1000, ets):		
Well yieldedGPM with a drawdown of Meter Manufacturer: Meter Model Number/Name: Totalizer Register Unit and Multiplier Factor (AF x .001, gal Installation Date: Meter installed by:	Installation Meter Serial Number: Type of Meter: I x 1000, ets): ent ertifying that this meter was insta	lled to manufacturer standards.	
Well yieldedGPM with a drawdown of         Meter Manufacturer:         Meter Model Number/Name:         Totalizer Register Unit and Multiplier Factor (AF x .001, gal         Installation Date:       Meter installed by:         Is This Meter (circle one):       New Repaired Replacement         Important:       By submitting the above information you are compared.	Installation Meter Serial Number: Type of Meter: L x 1000, ets): ent ent ertifying that this meter was insta proved meters is on the MDEQ w	lled to manufacturer standards.	
Well yieldedGPM with a drawdown of         Meter Manufacturer:         Meter Model Number/Name:         Totalizer Register Unit and Multiplier Factor (AF x .001, gal         Installation Date:       Meter installed by:         Is This Meter (circle one):       New Repaired Replaceme         Important: By submitting the above information you are constrained by:	Installation Meter Serial Number: Type of Meter: I x 1000, ets): ent ertifying that this meter was insta proved meters is on the MDEQ w me best of my knowledge.	lled to manufacturer standards.	

+\*\*

ł