

WILKINSON

R 2000

12-10-76

MISSISSIPPI
 BOARD OF WATER COMMISSIONERS
 416 North State Street
 Jackson, Mississippi 39201

WATER WELL DRILLERS LOG

Dec 10 1976
date well completed

14E Reuss Miller
firm name

Wilkinson
county well located

LANDOWNER:
 Chamme Bras
 Turn Bull Farm
 Woodville (mailing address)
 WELL LOCATION:
 sec. 41 T-1 N R-2 W
 6 miles South of Woodville
 (distance) (direction) (nearest town)

description of formations encountered	from	to
Old Clay	0	20
Old sand	20	70
White Chalk	70	115
Coarse sand & gravel	115	161

WELL PURPOSE: Barn
(home, irrigation, municipal, industrial)

WELL COMPLETION DATA:

(1) diameter (inches) 4"

(2) total depth (feet) 161

(3) static water level (feet) 75 below top of ground

(4) casing plastic bottom (material) (depth)

(size) if telescope see back.

(5) screen 6" 155 (length) (depth to top)

4" plastic (size) (material)

(6) pump 3 1/2 HP 12 (type power) (y/field gpm)

(7) electric log NA (yes or no)

(organization running log)


(8) how well bottom plugged
Washed plug

DRILLERS REMARKS:
A

RECEIVED
FEB - 7 '77

If well telescopes please sketch and show depths.

GROUND LEVEL

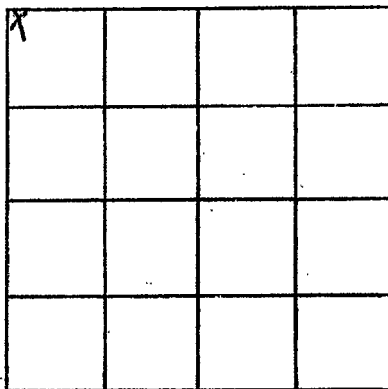

SECTION 41

Please indicate well location X.

ADDITIONAL INFORMATION

If more than one screen,
show locations of each on sketch.