

WILKINSON

R 2002

2-14-78

MISSISSIPPI BOARD OF WATER COMMISSIONERS  
416 North State Street  
Jackson, Mississippi 39201

WATER WELL DRILLERS LOG

Feb-14-1978  
date well completed

Reynolds Miller  
firm name

Wilkinson  
county well located

LANDOWNER:

Ray Alvine  
P.O. Woodville  
(mailing address)

description of formations encountered

from to

Clay	0	18
Red sand	18	42
White Chalk	42	100
lobbly sand	100	130
Coarse sand	130	160

WELL LOCATION:

sec. 19 T-1 S R-2 E W  
5 miles S-SE of Woodville  
(distance) (direction) (nearest town)

WELL PURPOSE:

Home  
(home, irrigation, municipal, industrial)

WELL COMPLETION DATA:

- (1) diameter (inches) 4"
- (2) total depth (feet) 160
- (3) static water level (feet) 70 below top of ground.
- (4) casing plastic bottom (material) (depth)
- (5) screen 10 150 (length) (depth to top)
- (6) pump 3/4 HP 12 (type power) (yield gpm)
- (7) electric log No (yes or no)


(organization running log)

(8) how well bottom plugged

Woodsen plug

DRILLERS REMARKS:


*[Handwritten signature]*

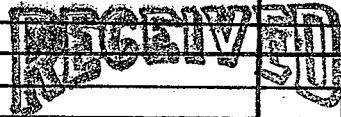

MAY 11 1978

If well telescopes please sketch and show depths.

GROUND LEVEL

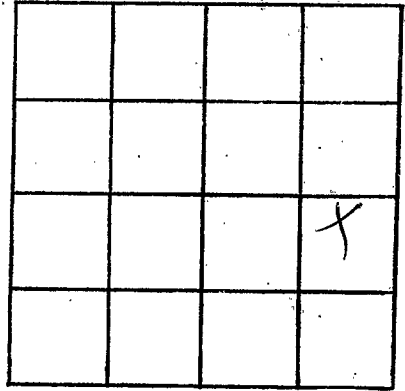

SECTION 19

Please indicate well location X.

ADDITIONAL INFORMATION

If more than one screen,  
show locations of each on sketch.