

WILKINSON

R 2003

7-25-78

MISSISSIPPI BOARD OF WATER COMMISSIONERS  
416 North State Street  
Jackson, Mississippi 39201

WATER WELL DRILLERS LOG

July 25 1978  
date well completed

Reynolds Miller  
firm name

Wilkinson  
county well located

LANDOWNER:

Mrs Anna Veal

Rt 4 box 470 Woodville  
(mailing address)

description of formations encountered

from to

hardy clay 27 27  
fine cherty sand 27 120  
Coarse sand 120 142

WELL LOCATION:


sec. 18 T 1 N R 2 E  
3 1/2 miles ESE of Woodville  
(distance) (direction) (nearest town)

WELL PURPOSE: home  
(home, irrigation, municipal, industrial)

WELL COMPLETION DATA:

- (1) diameter (inches) 4"
- (2) total depth (feet) 142
- (3) static water level (feet) 80 below top of ground.
- (4) casing plastic bottom  
(material) (depth)
- (5) screen 5' 137'  
(length) (depth to top)
- (6) pump 1/2 HP 10  
(type power) (yield gpm)
- (7) electric log no  
(yes or no)
- (8) how well bottom plugged wooden plug

DRILLERS REMARKS:

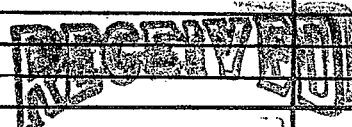


NOV - 7 1978

MISS. BD. OF WATER COMM

If well telescopes please sketch and show depths.

GROUND LEVEL

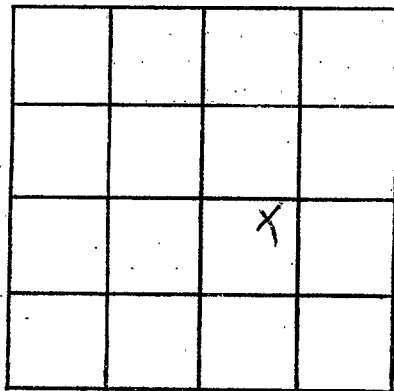

SECTION 18

Please indicate well location X.

ADDITIONAL INFORMATION

If more than one screen, show locations of each on sketch.