

MISSISSIPPI DEPARTMENT OF NATURAL RESOURCES
 Bureau of Land and Water Resources
 Southport Mall
 P.O. Box 10631
 Jackson, Mississippi 39209
WATER WELL DRILLERS LOG

Wilkinson
R 3004

5-18 19 Rayborn Drill. & Const. Co. Wilkinson
 date well completed firm name county well located

LANDOWNER:
New & Hughes
Natchez, MS
 (mailing address)

WELL LOCATION:
 sec. 13 T 1 N R 3 E
 S W
 (distance) miles (direction) of (nearest town)

WELL PURPOSE:
 (home, irrigation, municipal, industrial)

WELL COMPLETION DATA:
 (1) diameter (inches) 3"
 (2) total depth (feet) 503'
 (3) static water level (feet) 200' below above top of ground.
 (4) casing Blk, 503'
 (material) (depth)
3" If telescope see back.
 (size)
 (5) screen 20', 483
 (length) (depth to top)
3", slotted Pipe
 (size) (material)
 (6) pump -, 50 gpm
 (HP) (yield gpm)
 (type power)
 (7) electric log no
 (yes or no)
 (organization running log)

description of formations encountered	from	to
<u>Top soil</u>	<u>0</u>	<u>10</u>
<u>gravel</u>	<u>10</u>	<u>35</u>
<u>chalk</u>	<u>35</u>	<u>300</u>
<u>sand</u>	<u>300</u>	<u>335</u>
<u>Chalk.</u>	<u>335</u>	<u>430</u>
<u>sand</u>	<u>430</u>	<u>445</u>
<u>chalk</u>	<u>445</u>	<u>490</u>
<u>sand</u>	<u>490</u>	<u>503</u>

w. Seal lat #1

DEPT. OF NATURAL RESOURCES
 BUREAU OF LAND & WATER RESOURCES

MAY 21 1982


RECEIVED

(8) how well bottom plugged wood plug

DRILLERS REMARKS:

If well telescopes please
sketch and show depths.

GROUND LEVEL

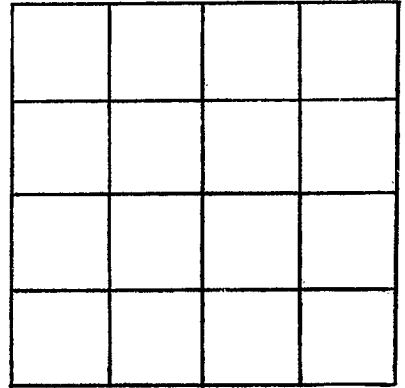

SECTION _____

Please indicate well location X.

ADDITIONAL INFORMATION

If more than one screen,
show locations of each on sketch.