

MISSISSIPPI DEPARTMENT OF NATURAL RESOURCES

Bureau of Land and Water Resources

Southport Mall

P.O. Box 10631

Jackson, Mississippi 39209

WATER WELL DRILLERS LOG

Wilkinson  
R2005

June 2 1982  
date well completed

Rever-willie Wilkinson  
firm name

county well located

LANDOWNER:  
J. W. Stockitt  
Woodville  
(mailing address)

WELL LOCATION:  
sec 33 T 1 N R 20 W  
5 miles south of woodville  
(distance) (direction) (nearest town)

WELL PURPOSE: house  
(home, irrigation, municipal, industrial)

WELL COMPLETION DATA:

(1) diameter (inches) 4"

(2) total depth (feet) 89

(3) static water level (feet) 60 below above top of ground.

(4) casing plastic bottom  
(material) (depth)

(size) If telescope see back.

(5) screen 5' 84'  
(length) (depth to top)

4" plastic  
(size) (material)

(6) pump 1/2 10  
(HP) (yield gpm)

elect  
(type power)

(7) electric log no  
(yes or no)

(organization running log)

description of formations encountered	from	to
Clay	0	10
Clay & gravel	10	25
Red cherty sand	25	45
Red sand	45	70
Coarse sand	70	89

(8) how well bottom plugged  
back wash

DRILLERS REMARKS:


DEPT. OF NATURAL RESOURCES  
BUREAU OF LAND & WATER RESOURCES

NOV 22 1982

RECEIVED

If well telescopes please sketch and show depths.

GROUND LEVEL

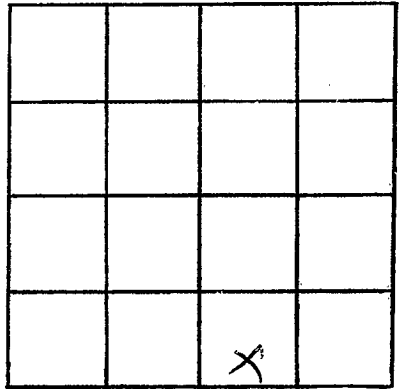

SECTION 33

Please indicate well location X.

ADDITIONAL INFORMATION

If more than one screen,  
show locations of each on sketch.