

MISSISSIPPI DEPARTMENT OF NATURAL RESOURCES
 Bureau of Land and Water Resources
 Southport Mall
 P.O. Box 10631
 Jackson, Mississippi 39209
WATER WELL DRILLERS LOG

Wilkinson
R 2008

Sept 21 1982 Recess Well for Wilkinson
 date well completed firm name county well located

LANDOWNER:
Bay Ridge B.C. Church
Woodville
 (mailing address)

description of formations encountered	from	to
	<u>clay</u>	<u>0</u>
<u>Red shaly sand</u>	<u>22</u>	<u>90</u>
<u>pink chalk</u>	<u>90</u>	<u>120</u>
<u>Coarse sand</u>	<u>120</u>	<u>150</u>

WELL LOCATION:
 sec 18 T 1 N R 2 W
4 miles S of Woodville
 (distance) (direction) (nearest town)

WELL PURPOSE: Church
 (home, irrigation, municipal, industrial)

WELL COMPLETION DATA:

(1) diameter (inches) 4"

(2) total depth (feet) 150'

(3) static water level (feet) 70' below above top of ground.

(4) casing plastic, bottom
 (material) (depth)

— if telescope see back.
 (size)

(5) screen 5', 145'
 (length) (depth to top)

4", plastic
 (size) (material)

(6) pump 1/2 hp, 10
 (HP) (yield gpm)

elect
 (type power)

(7) electric log no
 (yes or no)

—
 (organization running log)

(8) how well bottom plugged
back wash

DRILLERS REMARKS:
—


DEPT. OF NATURAL RESOURCES
 BUREAU OF LAND & WATER RESOURCES

FEB 24 1983

RECEIVED

If well telescopes please sketch and show depths.

GROUND LEVEL

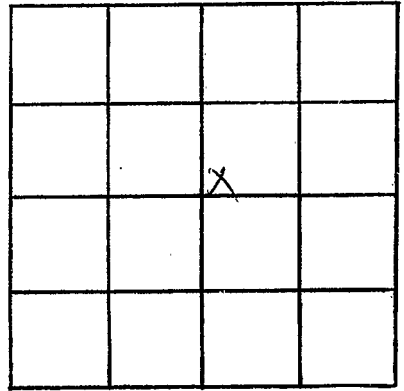

SECTION 18

Please indicate well location X.

ADDITIONAL INFORMATION

If more than one screen,
show locations of each on sketch.