

Wilkinson
R
2009

MISSISSIPPI DEPARTMENT OF NATURAL RESOURCES
 Bureau of Land and Water Resources
 Southport Mall
 P.O. Box 10631
 Jackson, Mississippi 39209
WATER WELL DRILLERS LOG

March 19 - 1983 Rivers Mill Dr Wilkinson
 date well completed firm name county well located

LANDOWNER:
Richard Fagan
Woodville
 (mailing address)

description of formations encountered	from	to
<u>Tapped</u>	<u>0</u>	<u>12</u>
<u>Sand + gravel</u>	<u>12</u>	<u>30</u>
<u>blue + gray chert</u>	<u>30</u>	<u>190</u>
<u>lime sand</u>	<u>190</u>	<u>220</u>
<u>med. coarse sand</u>	<u>220</u>	<u>237</u>

WELL LOCATION:
 sec. 26 T-1 N R-2 E
6 miles S-SW of Woodville
 (distance) (direction) (nearest town)

WELL PURPOSE: Camp
 (home, irrigation, municipal, industrial)

- WELL COMPLETION DATA:
- diameter (inches) 4"
 - total depth (feet) 237
 - static water level (feet) 140 below above top of ground.
 - casing plastic, bottom
 (material) (depth)
 _____ if telescope see back.
 (size)
 - screen 10 227
 (length) (depth to top)
4" plastic
 (size) (material)
 - pump 3/4 12
 (HP) (yield gpm)
shot
 (type power)
 - electric log no
 (yes or no)

 (organization running log)
 - how well bottom plugged back wash


DRILLERS REMARKS:

DEPT. OF NATURAL RESOURCES
 BUREAU OF LAND & WATER RESOURCES

JUN 17 1983
 RECEIVED

If well telescopes please sketch and show depths.

GROUND LEVEL

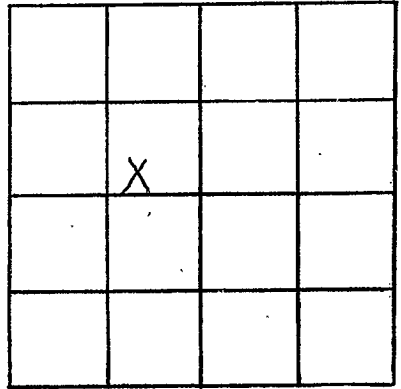

SECTION 26

Please indicate well location X.

ADDITIONAL INFORMATION

If more than one screen, show locations of each on sketch.