

Wilkinson  
R 2010

MISSISSIPPI DEPARTMENT OF NATURAL RESOURCES  
 Bureau of Land and Water Resources  
 Southport Mall  
 P.O. Box 10631  
 Jackson, Mississippi 39209  
**WATER WELL DRILLERS LOG**

9-2-83 19 Rayson Drilling Wilkinson  
 date well completed firm name county well located

LANDOWNER:  
Mrs. Lee Morris  
Rt 4, Box 25  
Woodville, MS 39669  
 (mailing address)

description of formations encountered	from	to
<u>Top Soil</u>	<u>0</u>	<u>5</u>
<u>Clay</u>	<u>6</u>	<u>80</u>
<u>Sand</u>	<u>81</u>	<u>125</u>

WELL LOCATION:  
 sec. 35 T. 10 N. R. 2 E.  
6 miles South of Woodville  
 (distance) (direction) (nearest town)

WELL PURPOSE: Private  
 (home, irrigation, municipal, industrial)

WELL COMPLETION DATA:

(1) diameter (inches) 4"

(2) total depth (feet) 125'

(3) static water level (feet) \_\_\_\_\_ below above top of ground.

(4) casing 4" PVC, 105'  
 (material) (depth)  
4" if telescope see back.  
 (size)

(5) screen 20' 105'  
 (length) (depth to top)  
4" PVC  
 (size) (material)

(6) pump 3/4 12  
 (HP) (yield gpm)  
electric  
 (type power)

(7) electric log NO  
 (yes or no)  
 \_\_\_\_\_  
 (organization running log)

(8) how well bottom plugged  
wood plug

DRILLERS REMARKS:


DEPT. OF NATURAL RESOURCES  
 BUREAU OF LAND & WATER RESOURCES

NOV 28 1983

RECEIVED

If well telescopes please sketch and show depths.

GROUND LEVEL

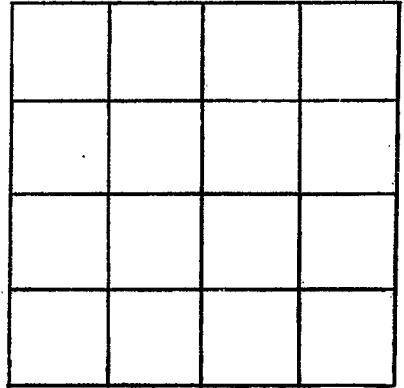

SECTION \_\_\_\_\_

Please indicate well location X.

ADDITIONAL INFORMATION

If more than one screen,  
show locations of each on sketch.