

MISSISSIPPI DEPARTMENT OF ENVIRONMENTAL QUALITY

Office of Land and Water Resources

P. O. Box 10631
Jackson, MS 39289-0631

WATER WELL DRILLERS LOG

COUNTY WELL LOCATED <i>Wilkinson</i>	
WELL NUMBER <i>R 2027</i>	CODED
DATE WELL COMPLETED <i>11-18-98</i>	

PERMIT NUMBER
NAME OF DRILLING FIRM <i>Professional Well</i>

NAME & MAILING ADDRESS OF LANDOWNER <i>CLIFF OGISO</i>			
<i>Scherry Rd. OFF Hwy 61.</i>			
WELL LOCATION:	SEC	TOWNSHIP	RANGE
	<i>35</i>	<i>1</i>	<i>2</i>
DISTANCE	DIRECTION	NEAREST TOWN	
<i>6</i> Miles	<i>South</i>	<i>Woodville</i>	
OTHER LANDMARK			
WELL PURPOSE: <input checked="" type="checkbox"/> Home Irrigation, Municipal, Industrial, Fish Pond, etc.			

PUMP DATA		
PUMP TYPE (Circle One): <input checked="" type="checkbox"/> Submersible, Turbine, Jet, Flowing Well, Other (Describe) _____		
POWER TYPE (Circle One): <input checked="" type="checkbox"/> Electric, Tractor, Diesel, Gasoline, Butane, Other (Describe) _____ H/P <i>3/4</i>		
Pump Capacity (GPM) <i>12</i>	No. of Stages <i>12</i>	Setting Depth <i>165'</i> FT.
PUMP TEST		
Well yielded _____ GPM with a drawdown of _____ ft. after _____ hours of pumping		

WELL DATA		
Well Depth <i>248</i>	Casing Diameter (In.) <i>4"</i>	Casing Length (Ft.) <i>228"</i>
Type of Casing <i>PVC</i>	Hole Depth <i>248</i>	Depth to Static Water Level <i>80"</i>

LOG DATA	
TYPE OF LOG RUN (Circle One): <input type="checkbox"/> No Log Run, Electric, Gamma Ray, Density, Sonic, Neutron, Other (Describe) _____	
Name of Organization Running Log	

TYPE OF COMPLETION: (Circle One or More): <input checked="" type="checkbox"/> Gravel Packed, Underreamed, Telescoped, <input type="checkbox"/> Natural Development, <input type="checkbox"/> Open Hole, <input type="checkbox"/> Other (Describe) _____		
--	--	--

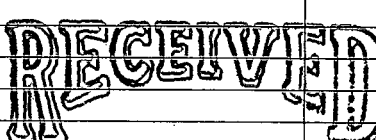
WELL GROUTED TO A DEPTH OF <i>10</i> FEET Type Grout (circle one): Cement, Bentonite, or <input checked="" type="checkbox"/> Mix

GEOLOGIC DATA (Office Use Only)			
Surface Elev.	Geologic Unit	Unit Thickness	Depth to Top
Subs. SWL	Date	Analysis	Aquifer Test

SCREEN DATA		
Diameter - Inches <i>4"</i>	Length - Feet <i>20</i>	Slot Size - Inches <i>0.010/0.010</i>
Screen Type <i>PVC</i>	Depth to Bottom - Feet <i>248.</i>	

Driller's Remarks
Top of Lap Pipe or Reduction in Casing
FEET <input type="checkbox"/> IF TELESCOPED OR MORE THAN ONE SCREEN: USE BACK PAGE

DESCRIPTION OF FORMATIONS ENCOUNTERED	FROM	TO
<i>Top soil</i>	<i>0</i>	<i>5</i>
<i>clay</i>	<i>5</i>	<i>20</i>
<i>Sand</i>	<i>20</i>	<i>40</i>
<i>clay</i>	<i>40</i>	<i>70</i>
<i>sand & gravel</i>	<i>70</i>	<i>90</i>
<i>clay</i>	<i>90</i>	<i>160</i>
<i>sand</i>	<i>160</i>	<i>165</i>
<i>clay</i>	<i>165</i>	<i>200</i>
<i>sand</i>	<i>200</i>	<i>205</i>
<i>clay</i>	<i>205</i>	<i>210</i>
<i>clay sand</i>	<i>210</i>	<i>248</i>

FORMATIONS (Continued)	FROM	TO
 JAN 13 1999 Dept. of Environmental Quality Office of Land & Water Resources		
IF MORE SPACE IS NEEDED, USE BACK		

If well telescopes please sketch and show depths.

GROUND LEVEL

		X	

SECTION _____

Please indicate well location X.

ADDITIONAL INFORMATION

If more than one screen,
show location of each on sketch.