

MISSISSIPPI DEPARTMENT OF ENVIRONMENTAL QUALITY

Office of Land and Water Resources

P. O. Box 10631

Jackson, MS 39289-0631

WATER WELL DRILLERS LOG

COUNTY WELL LOCATED
WILKINSON

WELL NUMBER 33 CODED

R-2031

DATE WELL COMPLETED
3-14-02

PERMIT NUMBER
079

NAME OF DRILLING FIRM
Reeves well ser.

NAME & MAILING ADDRESS OF LANDOWNER
Joe Whitaker

Whitaker Rd

Latitude: woodville

Longitude:

WELL LOCATION SEC TOWNSHIP RANGE

32 1 W 2 E

DISTANCE DIRECTION NEAREST TOWN

10 Miles SE of woodville

OTHER LANDMARK

WELL PURPOSE: Home, Irrigation, Municipal, Industrial, Fish Pond, etc.

PUMP DATA

PUMP TYPE (Circle One):
Submersible, Turbine, Jet, Flowing Well,
Other (Describe)

POWER TYPE (Circle One):
Electric, Tractor, Diesel, Gasoline, Butane,
Other (Describe) H/P 2

DESCRIPTION OF FORMATIONS ENCOUNTERED	FROM	TO
<u>Drift & Red Clay</u>	<u>0</u>	<u>20</u>
<u>Red Clay</u>	<u>20</u>	<u>60</u>
<u>Red Sand & Clay</u>	<u>60</u>	<u>75</u>
<u>sand & peegrowel</u>	<u>75</u>	<u>115</u>
<u>clay</u>	<u>115</u>	<u>170</u>
<u>Sand & Fine Sand</u>	<u>170</u>	<u>190</u>
<u>Sand & Coarse Sand</u>	<u>190</u>	<u>210</u>

WELL DATA


Well Depth <u>210'</u>	Casing Diameter (In.) <u>4"</u>	Casing Length (Ft.) <u>20'</u>
Type of Casing <u>pvc</u>	Hole Depth <u>210'</u>	Depth to Static Water Level <u>110'</u>

TYPE OF COMPLETION: (Circle One or More):
Gravel Packed, Underreamed, Telescoped,
Natural Development, Open Hole, Other
(Describe) 10 gal sand

WELL GROUTED TO A DEPTH OF 10 FEET
Type Grout (circle one): Cement, Bentonite, or Mix

SCREEN DATA

Diameter - Inches <u>4"</u>	Length - Feet <u>10'</u>	Slot Size - Inches <u>10 s. 67</u>
Screen Type <u>pvc</u>	Depth to Bottom - Feet <u>210'</u>	

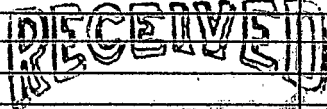

MAR 27 2002

Dept. of Environmental Quality
Office of Land & Water Resources

Top of Lap Pipe or Reduction in Casing

FEET IF TELESCOPED OR MORE THAN ONE SCREEN: USE BACK PAGE

I certify that the well was drilled, constructed and completed in accordance with all applicable Requirements of the Mississippi Department of Environmental Quality and/or the Mississippi Department of Health regulations and state laws.

Jimmy Reeves 0668
Signature of Licensed Driller and License No.

3-14-02
Date

Additional Information Required On Back

If well telescopes please sketch and show depths.

GROUND LEVEL

	X		

SECTION ~~30~~ 32

Please indicate well location X.

Pump Capacity (GPM)	No. of Stages	Setting Depth
60	8	140 FT.

PUMP TEST

Well yielded 50 GPM with a drawdown of 0 ft. after 1 hours of pumping

LOG DATA

TYPE OF LOG RUN (Circle One): No Log Run, Electric, Gamma Ray, Density, Sonic, Neutron, Other (Describe) _____

Name of Organization Running Log _____

GEOLOGIC DATA (Office Use Only)

Surface Elev.	Geologic Unit	Unit Thickness	Depth to Top
Subs. SWL	Date	Analysis	Aquifer Test

Driller's Remarks

If more than one screen, show location of each on sketch.