

1 days

91 11 00  
31 02 31

CODED

Wilkinson  
53  
7-68

MISSISSIPPI  
BOARD OF WATER COMMISSIONERS  
416 North State Street  
Jackson, Mississippi 39201

WATER WELL DRILLERS LOG

July 29 1968 *Perme well pumps - Wilkinson*  
date well completed firm name county well located

LANDOWNER: *Apple*  
*Treppendahl*  
*Woodville*  
(mailing address)

description of formations encountered	from	to
<i>Red sandy clay</i>	<i>0</i>	<i>27</i>
<i>Red chalky sand</i>	<i>27</i>	<i>90</i>
<i>white chalk</i>	<i>90</i>	<i>105</i>
<i>fine white sand</i>	<i>105</i>	<i>148</i>
<i>Coarse sand</i>	<i>148</i>	<i>163</i>

WELL LOCATION:  
sec. *18* T. *1* N. R. *1 E*  
*4 1/2* miles *5-SE* of *Woodville*  
(distance) (direction) (nearest town)

WELL PURPOSE: *Home*  
(home, irrigation, municipal, industrial)


WELL COMPLETION DATA:

- (1) diameter (inches) *4"*
- (2) total depth (feet) *163*
- (3) static water level (feet) *90* below top of ground
- (4) casing *Plastic bottom*  
(material) (depth)
- (size) if telescope see back.
- (5) screen *6* *157*  
(length) (depth) to top  
*4"* *Plastic*  
(size) (material)
- (6) pump *3/4 Sub 12*  
(HP) (yield gpm)  
*Elect*  
(type power)
- (7) electric log *No*  
(yes or no)

(organization running log)


(8) how well bottom plugged: *wooden plug*

DRILLERS REMARKS: *red well bad*

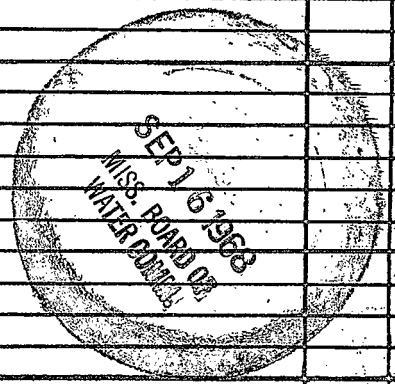

If well telescopes please sketch and show depths.

GROUND LEVEL

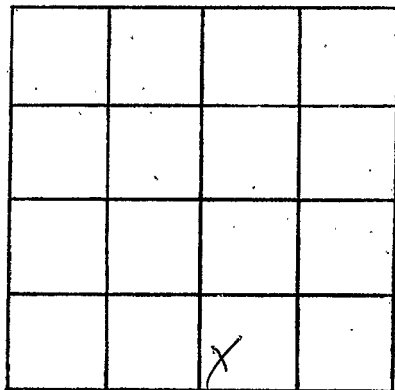

SECTION 18

Please indicate well location X.

ADDITIONAL INFORMATION

If more than one screen, show locations of each on sketch.