

Wilkinson
 S 5
 4-16-70

MISSISSIPPI
 BOARD OF WATER COMMISSIONERS
 416 North State Street
 Jackson, Mississippi 39201

WATER WELL DRILLERS LOG

April 16, 1970 Chester Peoples Wilkinson
 date well completed firm name county well located

LANDOWNER: John Beaman
Centerville

description of formations encountered	from	to
	Hard chalk	0
Red chalky sand	27	80
white chalk	80	118
lime sand	118	140
Diagnosed Sand	140	160

(mailing address)

WELL LOCATION:
 sec. 17 T. 1 R. 1 065
 6 1/2 miles SW Centerville
 (distance) (direction) (nearest town)

WELL PURPOSE: Drinking
 (home, irrigation, municipal, industrial)

WELL COMPLETION DATA:

- (1) diameter (inches) 4"
- (2) total depth (feet) 160
- (3) static water level (feet) 28 below top of ground. ~~above~~
- (4) casing Plastic, Balloum
 (material) (depth)
- _____ if telescope see back.
 (size)
- (5) screen 6' 150
 (length) (depth to top)
4" Plastic
 (size) (material)
- (6) pump 3/4 Sub 15
 (HP) (yield gpm)
Electric
 (type power)
- (7) electric log NO
 (yes or no)
- _____ (organization running log)


(8) how well bottom plugged
wooden plug

DRILLERS REMARKS:
New location

MAY 11 1970

If well telescopes please sketch and show depths.

GROUND LEVEL

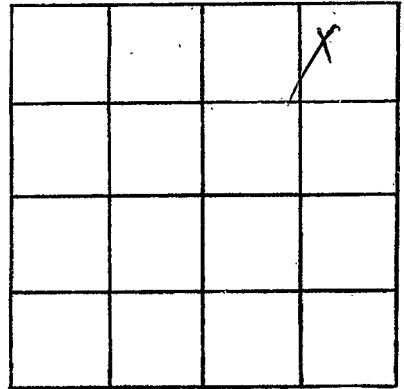

SECTION 17

Please indicate well location X.

ADDITIONAL INFORMATION

If more than one screen,
show locations of each on sketch.