

Wilkinson Co

MISSISSIPPI
BOARD OF WATER COMMISSIONERS
416 North State Street
Jackson, Mississippi 39201

CODED

WATER WELL DRILLERS LOG

Wilkinson Co

8/2

1970 HERRINGTON

date well completed

firm name

county well located

LANDOWNER: Oliver Conrad

description of formations encountered

from

to

route 1 box 366

Centerville Miss
(mailing address)

WELL LOCATION

sec 30 T 1 N S R 1 W

10 miles East of Woodville
(distance) (direction) (nearest town)

Clay	0	12
gravel	12	30
sand gravel	30	100
Clay	100	168
sand	168	180
Clay	180	230
sand & gravel	230	360

WELL PURPOSE: home
(home, irrigation, municipal, industrial)

WELL COMPLETION DATA:

- (1) diameter (inches) 2"
- (2) total depth (feet) 360'
- (3) static water level (feet) 140' below top of ground
- (4) casing galv 350' (material) (depth)

CODED

(size) if telescope see back.

- (5) screen 10' (length) (depth to top)
Stainless steel (size) (material)

- (6) pump 2 (HP) 16 (yield gpm)
Electric (type power)

- (7) electric log NO (yes or no)

(organization running log)

- (8) how well bottom plugged B.W.V


AUG 14 1970

DRILLERS REMARKS:

MISS. BD. OF
WATER COMM.

If well telescopes please sketch and show depths.

GROUND LEVEL

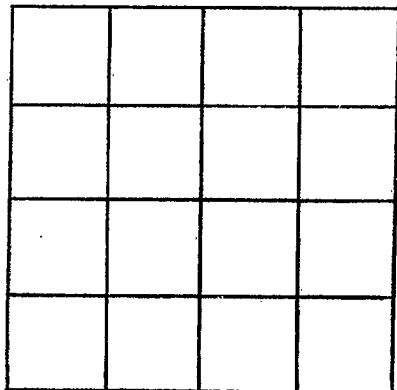

SECTION _____

Please indicate well location X.

ADDITIONAL INFORMATION

If more than one screen,
show locations of each on sketch.