

WILKINSON

57

9-25-70

MISSISSIPPI BOARD OF WATER COMMISSIONERS
416 North State Street
Jackson, Mississippi 39201

CODED

WATER WELL DRILLERS LOG

9-25-70 date well completed 1970 Guiner Water Well Driller Wilkinson firm name county well located

LANDOWNER:	description of formations encountered	from	to
Johnny Lewis			
(mailing address)	clay	2	125'
WELL LOCATION:	Sand	125	155'
sec. 8 T. 10 ^N R. 1 E			
3 miles SE of Woodville			
(distance) (direction) (nearest town)			
WELL PURPOSE: none			
(home, irrigation, municipal, industrial)			
WELL COMPLETION DATA:			
(1) diameter (inches) 2"			
(2) total depth (feet) 155'			
(3) static water level (feet) 55' below top of ground.			
(4) casing Galv. 148' (material) (depth)			
2" (size) if telescope see back.			
(5) screen 5' 148' (length) (depth to top)			
2" (size) SS (material)			
(6) pump 1 (HP) 6 GPM (yield gpm)			
elec (type power)			
(7) electric log No (yes or no)			
(organization running log)			
(8) how well bottom plugged Wood plug			
DRILLERS REMARKS:			


CODED

OCT 23 1970

MISS. BD. OF WATER COMM.

If well telescopes please sketch and show depths.

GROUND LEVEL

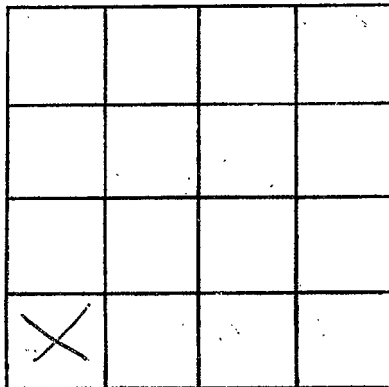

SECTION 8

Please indicate well location X.

ADDITIONAL INFORMATION

If more than one screen,
show locations of each on sketch.