

WILKINSON

58

2-26-71

MISSISSIPPI BOARD OF WATER COMMISSIONERS
416 North State Street
Jackson, Mississippi 39201

CODED

WATER WELL DRILLERS LOG

Feb 26 1971 date well completed
Chester Karnes wellhissan firm name
county well located

LANDOWNER: Marshall
Tupperdahl
Woodville, Miss.
(mailing address)

description of formations encountered	from	to
Red sandy clay	0	17
Red sand	17	62
chalk, sand & gravel	62	87
sand & gravel	87	98
white chalk	98	141
fine white sand	141	162
Coarse sand	162	171

WELL LOCATION:
sect 4 T 1 N R 1 E
7 miles S SE Woodville
(distance) (direction) (nearest town)

WELL PURPOSE: Farm
(home, irrigation, municipal, industrial)

- WELL COMPLETION DATA:
- (1) diameter (inches) 4"
 - (2) total depth (feet) 171
 - (3) static water level (feet) 90 below top of ground
 - (4) casing Plast Ballom (material) (depth)
 - (5) screen 6' 105' (length) (depth to top)
4" Plast (size) (material)
 - (6) pump 3/4 HP 15 (HP) (yield gpm)
elect (type power)
 - (7) electric log No (yes or no)

CODED

(8) how well bottom plugged
wooden plug


DRILLERS REMARKS:
old well not adequate

APR 27 1971

MISS. BD. OF WATER COMM.

If well telescopes please sketch and show depths.

GROUND LEVEL

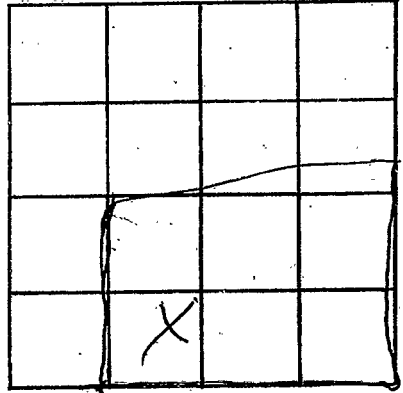

SECTION 49

Please indicate well location X.

ADDITIONAL INFORMATION

If more than one screen,
show locations of each on sketch.