

WILKINSON  
S-9  
6-25-71

MISSISSIPPI  
BOARD OF WATER COMMISSIONERS  
416 North State Street  
Jackson, Mississippi 39201

WATER WELL DRILLERS LOG

**CODED**

June 25 1971 Chester Renee Wilkinson  
date well completed firm name county well located

LANDOWNER: <u>Mrs. Mary Johnston</u>	description of formations encountered	from	to
<u>270 Woodville</u> (mailing address)	Red clay	0	25
WELL LOCATION: sec. <u>13</u> T. <u>1</u> N. R. <u>1</u> E. W. <u>6</u> (distance) miles (direction) of (nearest town)	Sand & gravel	25	70
WELL PURPOSE: <u>Home</u> (home, irrigation, municipal, industrial)	Sand & gravel	70	112
WELL COMPLETION DATA: (1) diameter (inches) <u>4"</u>	gravel & sand	112	120
(2) total depth (feet) <u>120</u>			
(3) static water level (feet) <u>92</u> below top of ground.			
(4) casing <u>Plast bottom</u> (material) (depth)			
(5) screen <u>6'</u> <u>1 1/4'</u> (length) (depth to top)			
(6) pump <u>1/2 HP</u> <u>Plast</u> (HP) (material)			
(7) electric log <u>Plast</u> (yes or no)			
(8) how well bottom plugged <u>wooden plug</u>			
DRILLERS REMARKS: <u>old Rod pump had</u>			


**CODED**

SEP 20 1971

MISS. BD. OF  
WATER COM. EX.

If well telescopes please sketch and show depths.

GROUND LEVEL

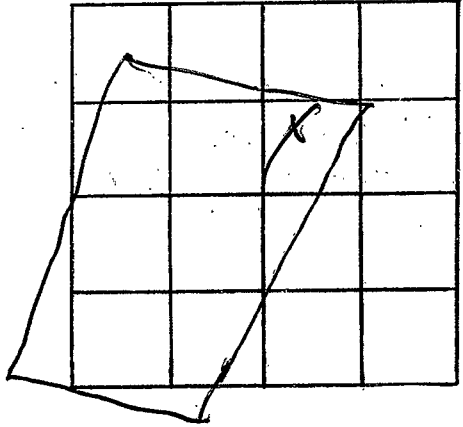

SECTION 13

Please indicate well location X.

ADDITIONAL INFORMATION

If more than one screen, show locations of each on sketch.