

**WILKINSON**  
**S 11**  
**11-2-73**

MISSISSIPPI  
 BOARD OF WATER COMMISSIONERS  
 416 North State Street  
 Jackson, Mississippi 39201

**WATER WELL DRILLERS LOG**

2<sup>nd</sup> Nov 1973 J. T. Conroy & Son Wilkinson  
 date well completed firm name county well located

**LANDOWNER:**  
Hattie Jones  
Centerville  
 (mailing address)

**WELL LOCATION:**  
 sec 39 T-1 N R-1 W  
12 miles W of Centerville  
 (distance) (direction) (nearest town)

**WELL PURPOSE:**  
 (home, irrigation, municipal, industrial)

**WELL COMPLETION DATA:**

(1) diameter (inches) 4

(2) total depth (feet) 114

(3) static water level (feet) 25 below above top of ground.

(4) casing pl, 108,  
 (material) (depth)  
 (size) if telescope see back.

(5) screen 6, 108  
 (length) (depth to top)  
4, pl  
 (size) (material)

(6) pump 1/2, 3  
 (HP) (yield gpm)  
9 feet  
 (type power)

(7) electric log \_\_\_\_\_  
 (yes or no)

\_\_\_\_\_  
 (organization running log)

(8) how well bottom plugged Wood


description of formations encountered	from	to
<u>Clay</u>	<u>0</u>	<u>25</u>
<u>Sand</u>	<u>25</u>	<u>35</u>
<u>Clay</u>	<u>35</u>	<u>90</u>
<u>Sand</u>	<u>90</u>	<u>114</u>
<b>CODED</b>		
<b>CODED</b>		
<b>DEC 11 1973</b>		

**DRILLERS REMARKS:**

MISSISSIPPI  
 BOARD OF WATER COMMISSIONERS

If well telescopes please sketch and show depths.

GROUND LEVEL

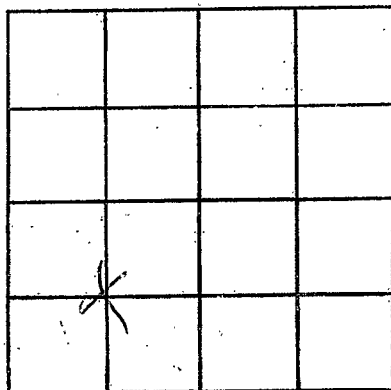

SECTION 38

Please indicate well location X.

ADDITIONAL INFORMATION

If more than one screen,  
show locations of each on sketch.