

Willberson
S 13
6-13-75

MISSISSIPPI
 BOARD OF WATER COMMISSIONERS
 416 North State Street
 Jackson, Mississippi 39201

CODED

WATER WELL DRILLERS LOG

June 13 1975 Beavers Well Drilling Willberson
 date well completed firm name county well located

LANDOWNER:
Tracy Smith
P.O. Box 963 Woodville
 (mailing address)

WELL LOCATION:
 sec. 26 T-1 N R-21W E 14E
6 miles South of Woodville
 (distance) (direction) (nearest town)

WELL PURPOSE: Trailer
 (home, irrigation, municipal, industrial)

WELL COMPLETION DATA:

(1) diameter (inches) 4"

(2) total depth (feet) 198

(3) static water level (feet) 90 below above top of ground.

(4) casing plastic, bottom
 (material) (depth)

6' If telescope see back.
 (size)

(5) screen 6' 192
 (length) (depth to top)

4" plastic
 (size) (material)

(6) pump Sub 10
 (HP) (yield gpm)

elect
 (type power)

(7) electric log no
 (yes or no)

(organization running log)

description of formations encountered	from	to
<u>Clay</u>	<u>0</u>	<u>12</u>
<u>Red sand</u>	<u>12</u>	<u>87</u>
<u>Coarse gravel</u>	<u>87</u>	<u>104</u>
<u>White Chalk</u>	<u>104</u>	<u>136</u>
<u>Coarse sand</u>	<u>136</u>	<u>180</u>
<u>Gravel</u>	<u>180</u>	<u>198</u>


(8) how well bottom plugged
Wooden plug

DRILLERS REMARKS:
new trailer site

SEP - 9 1975

If well telescopes please sketch and show depths.

GROUND LEVEL

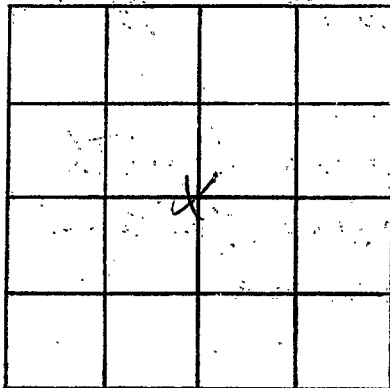

SECTION *26*

Please indicate well location X.

ADDITIONAL INFORMATION

If more than one screen, show locations of each on sketch.