

Office of Land and Water Resources

Jackson, MS 39289-0631

WATER WELL DRILLERS LOG

COUNTY WELL LOCATED	
Wilkinson	
WELL NUMBER	CODED
S 59	
DATE WELL COMPLETED	
6-21-04	

PERMIT NUMBER
NAME OF DRILLING FIRM Fitzgerald Well Service

NAME & MAILING ADDRESS OF LANDOWNER

Otis Fleming,
Whitestown Rd.

Latitude:
Longitude:

WELL LOCATION.	SEC	TOWNSHIP	RANGE
	19	1	1

DISTANCE DIRECTION NEAREST TOWN

7 Miles East of Knoxville

OTHER LANDMARK

WELL PURPOSE: Home, Irrigation, Municipal, Industrial, Fish Pond, etc.

[illegible]

WELL DATA		
Well Depth 160	Casing Diameter (In.) 4"	Casing Length (Ft.) 150'
Type of Casing PVC	Hole Depth 160'	Depth to Static Water Level 90'
TYPE OF COMPLETION: (Circle One or More): <u>Gravel Packed</u> , Underreamed, Telescoped, Natural Development, Open Hole, Other (Describe) _____		
WELL GROUTED TO A DEPTH OF <u>10</u> FEET Type Grout (circle one): Cement, Bentonite, or <u>Mix</u>		

SCREEN DATA		
Diameter - Inches 4"	Length - Feet 10'	Slot Size - Inches .010
Screen Type PVC		Depth to Bottom - Feet 160'

I certify that the well was drilled, constructed and completed in accordance with all applicable Requirements of the Mississippi Department of Environmental Quality and/or the Mississippi Department of Health regulations and state laws.


Brad Stapp 029.
Signature of Licensed Driller and License No.

6-21-04
Date

Additional Information Required On Back

If well telescopes please
sketch and show depths.

GROUND LEVEL

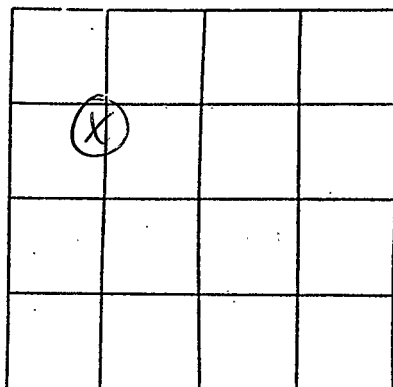

SECTION 19

Please indicate well location X.

Pump Capacity (GPM)	No. of Stages	Setting Depth	
<u>12</u>	<u>12</u>	<u>120'</u>	FT.

PUMP TEST

Well yielded _____ GPM with
a drawdown of _____ ft.
after _____ hours of pumping

LOG DATA

TYPE OF LOG RUN (Circle One): _____ No Log Run,
Electric, Gamma Ray, Density, Sonic, Neutron,
Other (Describe) _____

Name of Organization Running Log _____

GEOLOGIC DATA (Office Use Only)

Surface Elev.	Geologic Unit	Unit Thickness	Depth to Top
Subs. SWL	Date	Analysis	Aquifer Test

Driller's Remarks

If more than one screen,
show location of each on sketch.