
State W	ell Report	For Office Use Only:		
	urt 1			
Mississippi Department	of Environmental Quality ad Water Resources	Aquifer:		
	ox 10631	Well #:		
	S 39289-0631	L. S. Elevation:		
	961-5210 6938 (fax)	E-log #:		
	L			
State Law requires that this report be prepared by the driller in detail and filed with the Department within				
30 days of completion of drilling of the well. Well Owner Information	Well	Location		
Owner Name Frank Johnson	Latitude: 31 • 05 • 06	" Longitude: <u>91 • 15 · 32</u> "		
Mailing Address: 8907 Kindle tree Dr	Method of Lat/Long (circle or	e): Conventional Survey,		
	USGS quad; Hand-held	GPS, Survey-grade GPS		
Baton Rouge, La 70817 City State Zip Code				
	Distance Direction	Nearest Town		
Telephone No. (225. 328 - 054)	<u>3</u> Miles <u>E</u>	Nearest Town of <u>Woody</u> , Ile		
Well Data				
		Other:		
Purpose of Well (circle one) Home Industrial Public Supply	Inigation Tish Curtare			
Purpose of Well (circle one) Holdstill (circ				
If flowing, method of flow regulation: Valve Other (describe)				
Static Water Level:feet above or below (circle one) land surface Date measured:				
Method of Measurement (circle one) steel tape electric tap		10		
Hole depth: Well depth:	Well grouted to a depth of	<u> </u>		
Type of grout (circle one): Cement Bentonite Mix				
Type of grout (circle one):       Cement       Bentonite       Mix         Casing length: $140$ feet       Casing diameter: $4$ inches       Type of casing: $PVC$ Quarter of the second				
Screen length: 20_feet Screen diameter: 4inches Type of screen: 400				
Screen slot size: <u>.010</u> inches Setting depth: From <u>140</u> feet to <u>60</u> feet				
Type of completion (circle all applicable): Gravel packed Underreamed Telescoped Open hole Natural Development				
Other (describe):				
TOP OF IMP PIPE OF TOBUCCION		creen, describe on back of page		
Logs run (circle all applicable): No log run Electric Gamma R	ay Density Sonic Neutron	Other:		
Name of organization running log(s): I certify that the well was drilled, constructed, and completed i	n accordance with all applicab	le requirements of the Mississippi		
Department of Environmental Quality and/or the Mississippi I	epartment of Health regulatio	ns and state laws.		
RAYBORN DRILLING, INC. 0-6	, J	- ~ _		
Print Name of Water Well Contractor and License No.	<u> </u>	e of Water Well Contractor		
Print Name of water well Contractor and Election vol.	1			
		-\UY I J 2U[] 5%30.6 ∞730.6 0175		
		BY WWP		

If well telescopes please sketch below and show depths.



Description of Formations Encountered	From	To
Cray	6	30
Graul.	30	65
Red Sand	65	120
Medium Sand	120	160
		+
		+

If more than one screen, show location of each on sketch

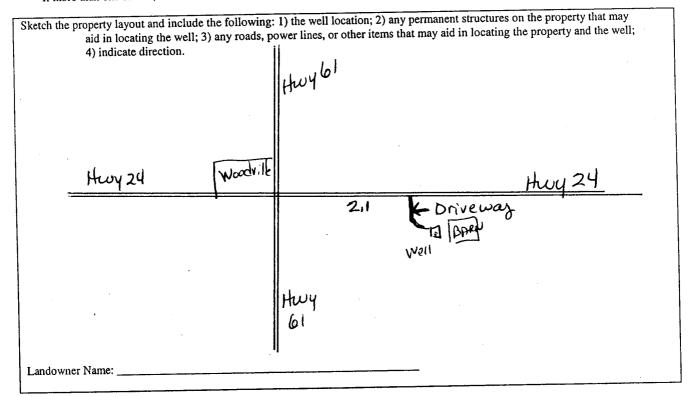

Signature of Water Well Contractor

REGEIVED NOV 1 5 2011 BY: MUNR

STATE WELL REPORT				
County:       Wilkinson       Pump Installer's         Permit #:	Impletion Report       For Office Use Only:         of Environmental Quality       Aquifer:         Aquifer:       Well #:			
This report should be prepared by the pump installer in detail and filed with the Department within 30 days of the installation of pump.				
Well Owner Information Owner Name: Frank Johnson Mailing Address: 8907 Kindletree BR La 70817 City State Zip Code Telephone No. 255 328-0541	Well Location         Latitude: <u>31-05-06</u> Longitude: <u>91-15-32</u> Method of Lat/Long (circle one): Conventional Survey,         USGS quad, Hand-held GPS, Survey-grade GPS <u>NW 14 NW 14 Sec</u> <u>Twn /N Rng IW</u> Distance       Direction       Nearest Town <u>3</u> Miles <u>E</u> of <u>Woodu</u> . <u>Ile</u>			
Pump Type Circle one         Air Lift       Jet         Bucket       Piston         Centrifugal       Rotary         Flowing Well         Other (specify):         Date Pump Installed:         ID-26-11         Rated Pump Capacity:	Power Type Circle one Diesel Engine Gasoline Engine Natural Gas Electric Motor Hand Tractor PTO Windmill Other (specify): Horse Power Rating of Motor: 1-HP 31 Constant Horse Power Rating of Motor: 1-HP 31 Constant Pressure Number of Stages: 10			
Pump Test Data         Date Well Tested:       10 - 26 - 11         Static Water Level (A):       80 Feet Below Land Surface         Pumping Water Level (B):       Feet Below Land Surface         Drawdown [(B) - (A)]:       Feet Below Land Surface         Test Pumping Rate:       10 Gallons Per Minute         Duration of Pump Test (minimum 4 hours):       hours	Method of Measuring Water Level         Circle one         Air Line       Electric Measuring Line         Steel Tape         Other (specify):         For flowing well, measured shut in head:         feet         Well yielded         feet after         hours of pumping			
I HEREBY CERTIFY that the above statements are true to the best <b>RAYBORN DRILLING, INC.</b> O-QO Print Name of Pump Installer and License No. (if applicable)	of my knowledge. Signature of Pump Installer			

SP NNR