

Wilkinson
S 2000
3-19-76

MISSISSIPPI
 BOARD OF WATER COMMISSIONERS
 416 North State Street
 Jackson, Mississippi 39201

WATER WELL DRILLERS LOG


March 19 ¹⁹ *76* *Reener Well Service* *Wilkinson*
 date well completed firm name county well located

LANDOWNER:	description of formations encountered	from	to
<i>Mr. Adolf Frenz</i> Frenz (mailing address)	<i>Red Clay</i> <i>Red sand & gravel</i> <i>pink loess</i> <i>white chalk</i> <i>coarse white sand</i>	<i>0</i> <i>18</i> <i>50</i> <i>65</i> <i>120</i>	<i>18</i> <i>50</i> <i>65</i> <i>120</i> <i>156</i>
WELL LOCATION: sec. <i>23</i> T <i>L</i> N R <i>L</i> E W <i>4 1/2</i> miles <i>E-SE</i> of <i>Wochilla</i> (distance) (direction) (nearest town)			
WELL PURPOSE: <i>house</i> (home, irrigation, municipal, industrial)			
WELL COMPLETION DATA:			
(1) diameter (inches) <i>4"</i>			
(2) total depth (feet) <i>156</i>			
(3) static water level (feet) <i>100</i> below top of ground.			
(4) casing <i>plastic bottom</i> (material) (depth)			
If telescope see back. (size)			
(5) screen <i>6'</i> <i>150</i> (length) (depth to top)			
<i>4"</i> <i>plastic</i> (size) (material)			
(6) pump <i>3</i> <i>12</i> (HP) (yield gpm)			
<i>elect</i> (type power)			
(7) electric log <i>no</i> (yes or no)			
(organization running log)			
(8) how well bottom plugged <i>wooden</i>			
DRILLERS REMARKS: <i>old plastic Hit by lightning</i>			

JUN 9 1976
 MISSISSIPPI BOARD OF WATER COMMISSIONERS

If well telescopes please sketch and show depths.

GROUND LEVEL

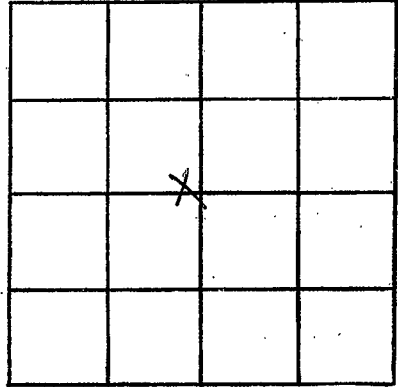

SECTION 23

Please indicate well location X.

ADDITIONAL INFORMATION

If more than one screen, show locations of each on sketch.