

Wilkinson

S 2001

4-29-76

MISSISSIPPI BOARD OF WATER COMMISSIONERS
416 North State Street
Jackson, Mississippi 39201

WATER WELL DRILLERS LOG

April 29 1976 Reynolds Wilkinson
date well completed firm name county well located


LANDOWNER:
Martie Taylor
Centerville Miss
(mailing address)

description of formations encountered	from	to
<u>Clay</u>	<u>0</u>	<u>10</u>
<u>Blue Chalk</u>	<u>10</u>	<u>70</u>
<u>Blue Chalk sand</u>	<u>70</u>	<u>120</u>
<u>Coarse sand</u>	<u>120</u>	<u>136</u>

WELL LOCATION:
sec 47 T-1 (N) R-1
7 miles 3-SW of Centerville
(distance) (direction) (nearest town)

WELL PURPOSE: Trailer
(home, irrigation, municipal, industrial)

- WELL COMPLETION DATA:
- (1) diameter (inches) 4"
 - (2) total depth (feet) 136
 - (3) static water level (feet) 118 below top of ground.
 - (4) casing Plastic Bottom
(material) (depth)
 - If telescope see back.
(size)
 - (5) screen 6" 130'
(length) (depth to top)
 - 4" Plastic
(size) (material)
 - (6) pump NO pump
(HP) (yield gpm)
 - elect
(type power)
 - (7) electric log NO
(yes or no)
 - Wagner
(organization running log)
 - (8) how well bottom plugged Wagner plug

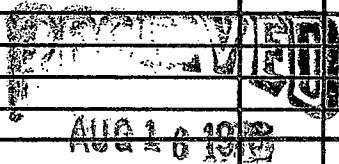


DRILLERS REMARKS:
This is Bad Country to drill wells

MISS. BO. OF WATER COMMISSIONERS

If well telescopes please sketch and show depths.

GROUND LEVEL

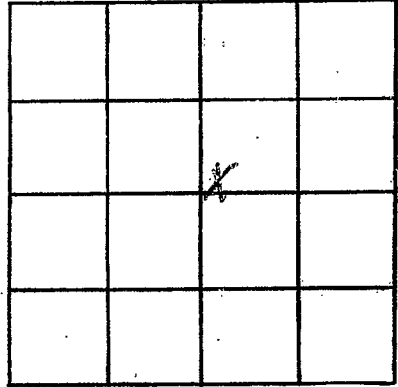

SECTION 47

Please indicate well location X.

ADDITIONAL INFORMATION

If more than one screen, show locations of each on sketch.