

**MISSISSIPPI DEPARTMENT OF NATURAL RESOURCES**  
**Bureau of Land and Water Resources**  
 Southport Mall  
 P.O. Box 10631  
 Jackson, Mississippi 39209  
**WATER WELL DRILLERS LOG**

WILKINSON  
S 20002

June 6 1985 Recess Well Co Wilkinson  
 date well completed firm name county well located

**LANDOWNER:**  
Ron M.G. Powell  
At Woodville  
 (mailing address)

description of formations encountered	from	to
<u>Red Clay</u>	<u>0</u>	<u>24</u>
<u>Red Cherty Sand</u>	<u>24</u>	<u>85</u>
<u>pink loam</u>	<u>85</u>	<u>103</u>
<u>small gravel sand</u>	<u>103</u>	<u>128</u>

**WELL LOCATION:**  
 sec. 4 T. 1 N. R. 1 E.  
8 miles east of Woodville  
 (distance) (direction) (nearest town)

**WELL PURPOSE:** house  
 (home, irrigation, municipal, industrial)

- WELL COMPLETION DATA:**
- (1) diameter (inches) 4"
  - (2) total depth (feet) 128
  - (3) static water level (feet) 70 below above top of ground.
  - (4) casing plastic bottom  
 (material) (depth)
  - (size) 1 If telescope see back.
  - (5) screen 5' 123'  
 (length) (depth to top)
  - (size) 4" plastic  
 (size) (material)
  - (6) pump 1/2 hp plastic  
 (HP) (yield gpm)
  - (type power) elect
  - (7) electric log no  
 (yes or no)
  - (organization running log) ✓
  - (8) how well bottom plugged back wash


**RECEIVED**  
**IN**  
 MAR 14 1986

Department of Natural Resources  
 Bureau of Land & Water Resources

**DRILLERS REMARKS:**  
✓

If well telescopes please sketch and show depths.

GROUND LEVEL

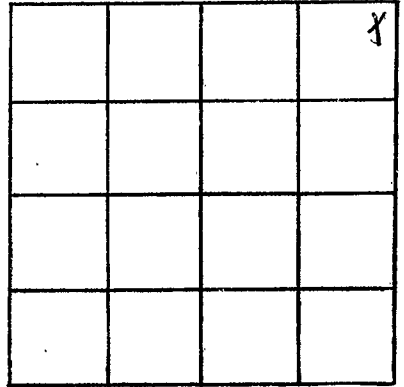

SECTION 4

Please indicate well location X.

ADDITIONAL INFORMATION

A series of horizontal lines for entering additional information.

If more than one screen, show locations of each on sketch.