

MISSISSIPPI DEPARTMENT OF NATURAL RESOURCES
 Bureau of Land and Water Resources
 Southport Mall
 P.O. Box 10631
 Jackson, Mississippi 39209
WATER WELL DRILLERS LOG

WILKINSON
50003

11/19 1985 Rayborn Drilling Co Wilkinson
 date well completed firm name county well located


LANDOWNER: <u>Johmnie J Leake</u>	description of formations encountered	from	to
<u>Rt 1 Box 243 A</u>			
<u>Centreville Ms 39631</u> (mailing address)	<u>Top Soil</u>	<u>0</u>	<u>15</u>
WELL LOCATION: sec <u>32</u> T <u>1</u> N R <u>1</u> E <u>7</u> miles <u>SE</u> of <u>Centreville</u> (distance) (direction) (nearest town)	<u>Gravel</u>	<u>15</u>	<u>30</u>
WELL PURPOSE: <u>private</u> (home, irrigation, municipal, industrial)	<u>White Chalk</u>	<u>30</u>	<u>40</u>
WELL COMPLETION DATA:	<u>sand</u>	<u>40</u>	<u>67</u>
(1) diameter (inches) <u>4"</u>	<u>Chalk</u>	<u>67</u>	<u>85</u>
(2) total depth (feet) <u>113'</u>	<u>Sand</u>	<u>85</u>	<u>113</u>
(3) static water level (feet) <u>60'</u> <u>below</u> above top of ground.			
(4) casing <u>PVC Pipe</u> , <u>93'</u> (material) (depth) <u>4"</u> (size) If telescope see back.			
(5) screen <u>20'</u> , <u>93'</u> (length) (depth to top) <u>4"</u> , <u>Slotted PVC Pipe</u> (size) (material)			
(6) pump <u>1</u> , <u>15</u> (HP) (yield gpm) <u>electric</u> (type power)			
(7) electric log <u>no</u> (yes or no) (organization running log)			
(8) how well bottom plugged <u>wood</u>			

DRILLERS REMARKS: _____

ABA
 11/19/85
 Department of Natural Resources
 Bureau of Land and Water Resources
 Jackson, Mississippi 39209

If well telescopes please sketch and show depths.

GROUND LEVEL

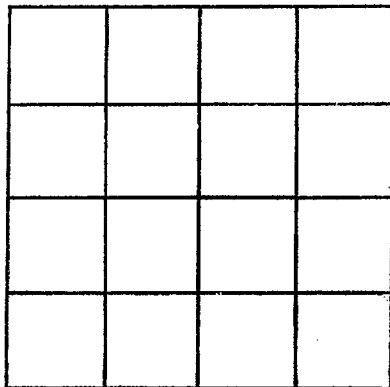

SECTION _____

Please indicate well location X.

ADDITIONAL INFORMATION

If more than one screen, show locations of each on sketch.