

MISSISSIPPI DEPARTMENT OF NATURAL RESOURCES

Bureau of Land and Water Resources

Southport Mall

P.O. Box 10631

Jackson, Mississippi 39209

WATER WELL DRILLERS LOG

Griner Drilling Service, Inc.

Wilkinson

WILKINSON
S 2004

12-8-86
date well completed

Griner Drilling Service, Inc.
firm name

Wilkinson
county well located

LANDOWNER:	description of formations encountered	from	to
Murco Drilling Corp. 1908 Beck Bldg. Shreveport, La. 71101 (mailing address)	clay, sand pea gravel	0	200
WELL LOCATION: sec. 2 T 10 N R 1 E Hughes Centreville Eastville miles. (direction) of (nearest town)	SAND, pea gravel	200	252
WELL PURPOSE: oilfielding (home, irrigation, municipal, industrial) No. 1 Charles H. Campbell			
WELL COMPLETION DATA:			
(1) diameter (inches) 4"			
(2) total depth (feet) 252'			
(3) static water level (feet) 96' Below above top of ground.			
(4) casing Steel 252' (material), (depth) 4" (size) If telescope see back.	No. 1 Water Well on location		
(5) screen 20' 232' (length), (depth to top) 4" stainless (size), Steel (material)			
(6) pump 5 50 (HP) (yield gpm)			
230 volt 3 phase (type power) pump-motor			
(7) electric log (yes or no)			
(organization running log)			
(8) how well bottom plugged 4" back wash valve-			
DRILLERS REMARKS:			


RECEIVED

JAN 14 1987

Department of Natural Resources
Bureau of Land & Water Resources

If well telescopes please sketch and show depths.

GROUND LEVEL

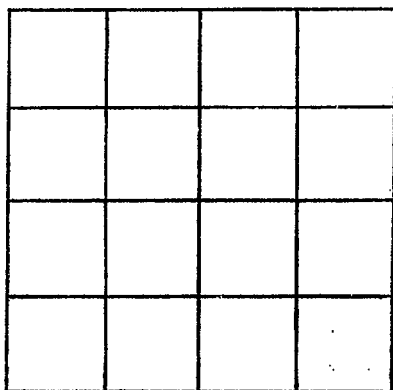

SECTION _____

Please indicate well location X.

ADDITIONAL INFORMATION

If more than one screen,
show locations of each on sketch.