

MISSISSIPPI DEPARTMENT OF NATURAL RESOURCES

Bureau of Land and Water Resources

Southport Mall

P.O. Box 10631

Jackson, Mississippi 39209


WATER WELL DRILLERS LOG

WILKINSON
S 2005

12-8-86 Griner Drilling Service, Inc. Wilkinson
date well completed firm name county well located

LANDOWNER:	description of formations encountered	from	to
Murco Drilling Corp. 1908 Beck Bldg. Shreveport, La. 7001 (mailing address)	clay, sand, pea gravel	0	200
WELL LOCATION: sec. 2 T 10 N R 1 W Hughes Eastern Co. No. 1 Charles Campbell Centreville miles (direction) (nearest town)	sand, pea gravel	200	252
WELL PURPOSE: <u>oil field rig</u> (home, irrigation, municipal, industrial)	clay, sand, mostly clay	252	609
WELL COMPLETION DATA: (1) diameter (inches) <u>3"</u>	sand with breaks of clay, mostly sand	609	693
(2) total depth (feet) <u>924'</u>	clay, sand, mostly clay	693	924
(3) static water level (feet) <u>190'</u> (below/above top of ground)			
(4) casing <u>steel 693'</u> (material) (depth) <u>3"</u> (size) If telescope see back.			
(5) screen <u>63' 630'</u> (length) (depth to top) <u>3" perforated</u> (size) (material)			
(6) pump <u>AC</u> (HP) <u>70</u> (yield gpm) (type power)			
(7) electric log <u>(yes or no)</u> (organization running log)			
(8) how well bottom plugged <u>orange peel</u>			

No. 2 Water Well

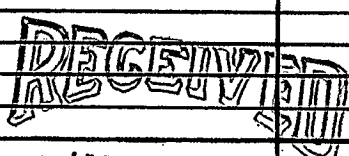


JAN 14 1987

Department of Natural Resources
Bureau of Land & Water Resources

DRILLERS REMARKS:

If well telescopes please sketch and show depths.

GROUND LEVEL

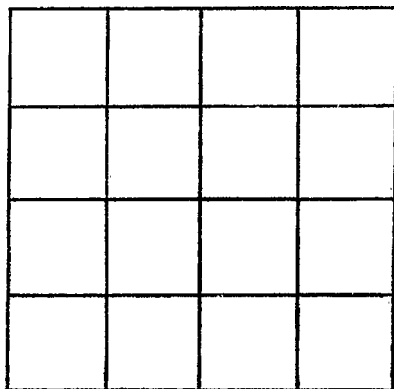

SECTION _____

Please indicate well location X.

ADDITIONAL INFORMATION

If more than one screen, show locations of each on sketch.