

CODED

CODED

Wilkinson
T6
12-66

MISSISSIPPI
 BOARD OF WATER COMMISSIONERS
 416 North State Street
 Jackson, Mississippi 39201

WATER WELL DRILLERS LOG

Dec 19 date well completed G.B. KEEVES WELL PUMP firm name Wilkinson county well located

LANDOWNER: L.H. Chapman
 Centerville, Miss (mailing address)

description of formations encountered	from	to
top clay	0	12
cherty sand	12	82
white chalk	82	100
medium coarse white sand	100	128

WELL LOCATION:
 sec. 15 T. 1 N. R. 1 E
 2 miles S of Centerville
 (distance) (direction) (nearest town)

WELL PURPOSE: Domestic
 (home, irrigation, municipal, industrial)

WELL COMPLETION DATA:

- (1) diameter (inches) 4
- (2) total depth (feet) 128
- (3) static water level (feet) 50 below top of ground.
- (4) casing Plastic Bottom (material) (depth)
- 4 (size) if telescope see back.
- (5) screen 6' 122 (length) (depth-to top)
- 4' Plastic (size) (material)
- (6) pump 1/2 HP sub 12 (HP) (yield gpm)
- Electric (type power)
- (7) electric log NO (yes or no)
- (organization running log)
- (8) how well bottom plugged plug wooden


CODED



DRILLERS REMARKS:

If well telescopes please sketch and show depths.

GROUND LEVEL

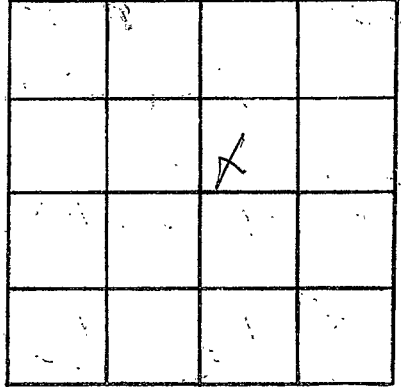

SECTION _____

Please indicate well location X.

ADDITIONAL INFORMATION

Lined area for additional information.

If more than one screen, show locations of each on sketch.