

CODED

CODED

MISSISSIPPI  
 BOARD OF WATER COMMISSIONERS  
 416 North State Street  
 Jackson, Mississippi 39201

WATER WELL DRILLERS LOG

Wilkinson  
TR  
11-67

Nov. 15 1967 Renew Well Drilling Wilkinson  
 date well completed firm name county well located

LANDOWNER: Charles Campbell - Centerville  
 (mailing address)

description of formations encountered	from	to
<u>Red clay</u>	<u>0</u>	<u>10</u>
<u>white chalk</u>	<u>10</u>	<u>70</u>
<u>Red sand gravel</u>	<u>70</u>	<u>120</u>
<u>Red gravel</u>	<u>120</u>	<u>127</u>

WELL LOCATION:  
 sec. 13 T 1 N R. 1 E  
6 miles west of Centerville  
 (distance) (direction) (nearest town)

WELL PURPOSE: Home  
 (home, irrigation, municipal, industrial)

WELL COMPLETION DATA:

- (1) diameter (inches) 4"
- (2) total depth (feet) 127'
- (3) static water level (feet) 85 below above top of ground.
- (4) casing Plastic Bottom  
 (material) (depth)
- (size) if telescope see back.
- (5) screen 6' 121'  
 (length) (depth to top)
- 4" Plastic  
 (size) (material)
- (6) pump 3/4 sub 14  
 (HP) (yield gpm)
- Alert  
 (type power)
- (7) electric log no  
 (yes or no)
- (organization running log)

CODED


(8) how well bottom plugged wooden plug

DRILLERS REMARKS:  
New location



If well telescopes please sketch and show depths.

GROUND LEVEL

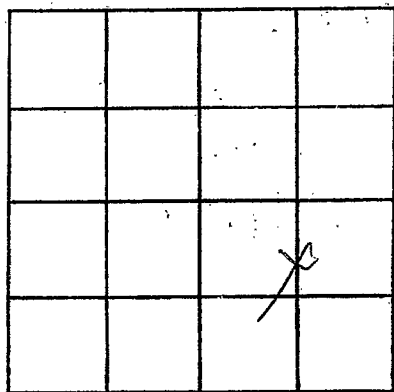

SECTION 13

Please indicate well location X.

ADDITIONAL INFORMATION

If more than one screen,  
show locations of each on sketch.