

WILKINSON
T 10
3-68

MISSISSIPPI
BOARD OF WATER COMMISSIONERS
416 North State Street
Jackson, Mississippi 39201

WATER WELL DRILLERS LOG

March 21 date well completed
H. Reneau & Sons firm name
Wilkinson county well located

LANDOWNER: J. Pleasant Baptist Church
P.O. Centerville
(mailing address)

description of formations encountered	from	to
Red Sandy clay	0	27
Red chalk	27	38
Keo gravel	38	41
Red chalk	41	60
pink sandy sand	60	100
white chalk	100	142
Coarse white sand	142	165

WELL LOCATION:
sec. 5 T. 10 N. R. 1 E
5 miles west of Centerville
(distance) (direction) (nearest town)

WELL PURPOSE: Church
(home, irrigation, municipal, industrial)


WELL COMPLETION DATA:

- (1) diameter (inches) 4"
- (2) total depth (feet) 165
- (3) static water level (feet) 73 below top of ground.
- (4) casing Plastic bottom
(material) (depth)
- (size) If telescope see back.
- (5) screen 6" 159'
(length) (depth to top)
4" Plastic
(size) (material)
- (6) pump 1/2 sub 12
(HP) (yield gpm)
Elect
(type power)
- (7) electric log No
(yes or no)

(organization running log)


(8) how well bottom plugged
wooden plug

DRILLERS REMARKS:
old shallow well dry.

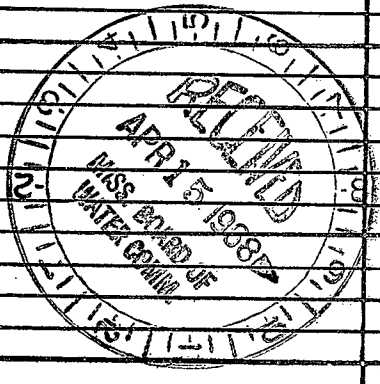

If well telescopes please sketch and show depths.

GROUND LEVEL

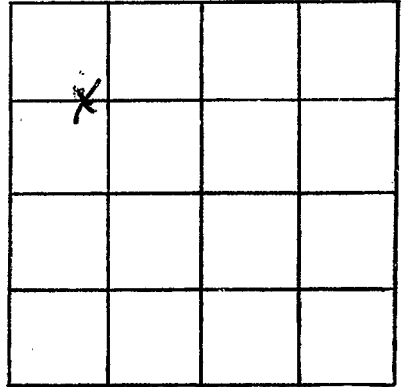

SECTION 2

Please indicate well location X.

ADDITIONAL INFORMATION

If more than one screen, show locations of each on sketch.