

CODED

Wilkinson
T 11
9-68

MISSISSIPPI
BOARD OF WATER COMMISSIONERS
416 North State Street
Jackson, Mississippi 39201

WATER WELL DRILLERS LOG

9-12 1968 Griner Water Well Co. Wilkinson
date well completed firm name county well located

LANDOWNER:

Jessie Cole
Centerville, Miss
(mailing address)

description of formations encountered

description of formations encountered	from	to
Top Soil	0	3
shale	3	40
gravel	40	60
sand	60	115
shale	115	140
sand	140	187

WELL LOCATION:

sec. 4 T. 2 S. R. 10
1 miles east of Centerville
(distance) (direction) (nearest town)


WELL PURPOSE:

Home
(home, irrigation, municipal, industrial)

WELL COMPLETION DATA:


- (1) diameter (inches) 2"
- (2) total depth (feet) 187'
- (3) static water level (feet) 40 ^{below}/_{above} top of ground.
- (4) casing Galv., 180'
(material) (depth)
2" if telescope see back.
(size)
- (5) screen 5", 180'
(length) (depth to top)
2", SS
(size) (material)
- (6) pump 1/2, 4
(HP) (yield gpm)
electric
(type power)
- (7) electric log no
(yes or no)
(organization running log)
- (8) how well bottom plugged wood plug

DRILLERS REMARKS:

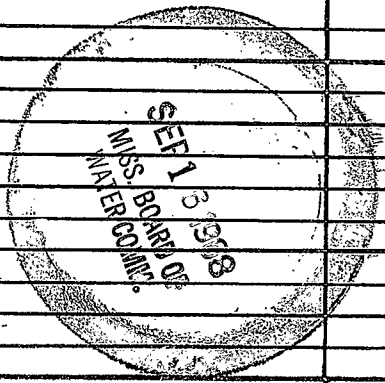

If well telescopes please sketch and show depths.

GROUND LEVEL

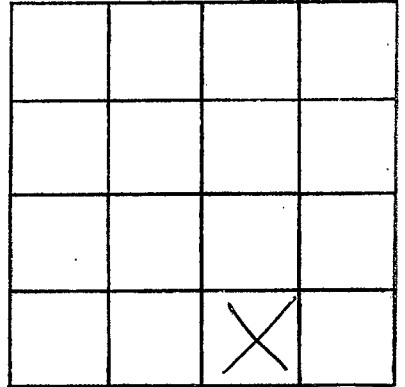

SECTION 4

Please indicate well location X.

ADDITIONAL INFORMATION

A series of horizontal lines for writing additional information.

If more than one screen, show locations of each on sketch.