

CODED

MISSISSIPPI
BOARD OF WATER COMMISSIONERS
416 North State Street
Jackson, Mississippi 39201

Wilkinson
T12
9-12-68

WATER WELL DRILLERS LOG

Wilkinson

9-12 1968 Grimes water well Inc. date well completed firm name county well located

LANDOWNER:

Vicki Moss

(mailing address)

description of formations encountered

from to

Top Soil
shale
gravel
Sand

0 3
3 40
40 60
60 115

WELL LOCATION:

sec. 4 T. 20 N R. 1 E
S W

1 miles east of Cantonville
(distance) (direction) (nearest town)

WELL PURPOSE:


(home, irrigation, municipal, industrial)

WELL COMPLETION DATA:

- (1) diameter (inches) 2"
- (2) total depth (feet) 115'
- (3) static water level (feet) 55' below top of ground.
- (4) casing Galv. 108' (material) (depth)
2" (size) if telescope see back.
- (5) screen 5' 108' (length) (depth to top)
2" 55' (size) (material)
- (6) pump 1/2 HP 4 (HP) (yield gpm)
electric (type power)
- (7) electric log no (yes or no)

(organization running log)

(8) how well bottom plugged Wood plug

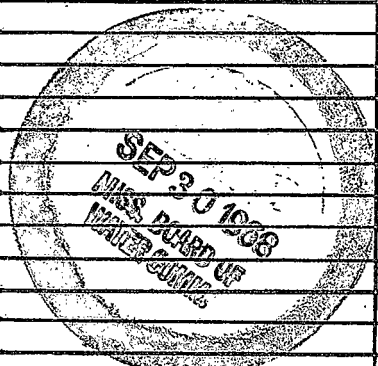

DRILLERS REMARKS:

If well telescopes please sketch and show depths.

GROUND LEVEL

		X	

SECTION _____

Please indicate well location X.

ADDITIONAL INFORMATION

If more than one screen,
show locations of each on sketch.